


T. 24S., R. 34E., W. M.

SW1/4 SE1/4 SEC. 19

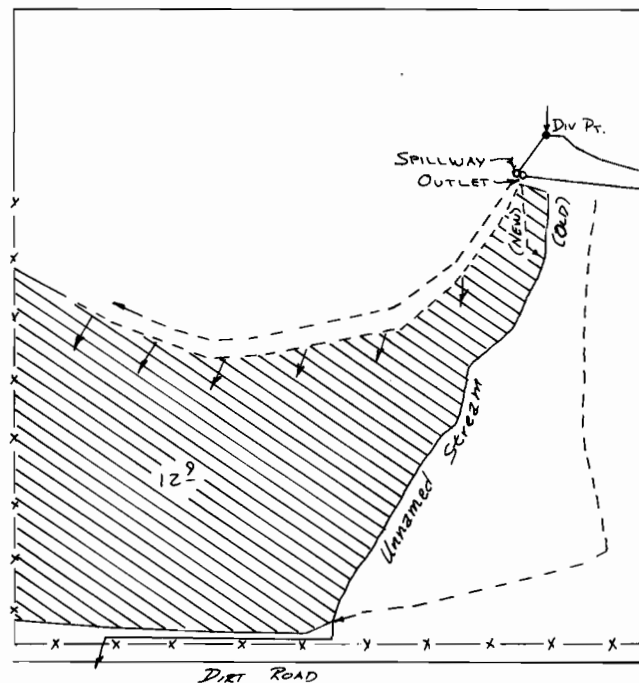

SCALE 1" = 400'

Div. Pt. Loc: 1060' N. & 1110' E. FROM S 1/4 COR. SECTION 19

**FINAL PROOF SURVEY**  
UNDER

R-67714                      R-10199  
Application No. **67715**      Permit No. **49172**  
IN NAME OF

**CLARENCE L. PHILLIS**

Surveyed 7-30-1987, by V.L. Church