


T.6S R.6W W.M.

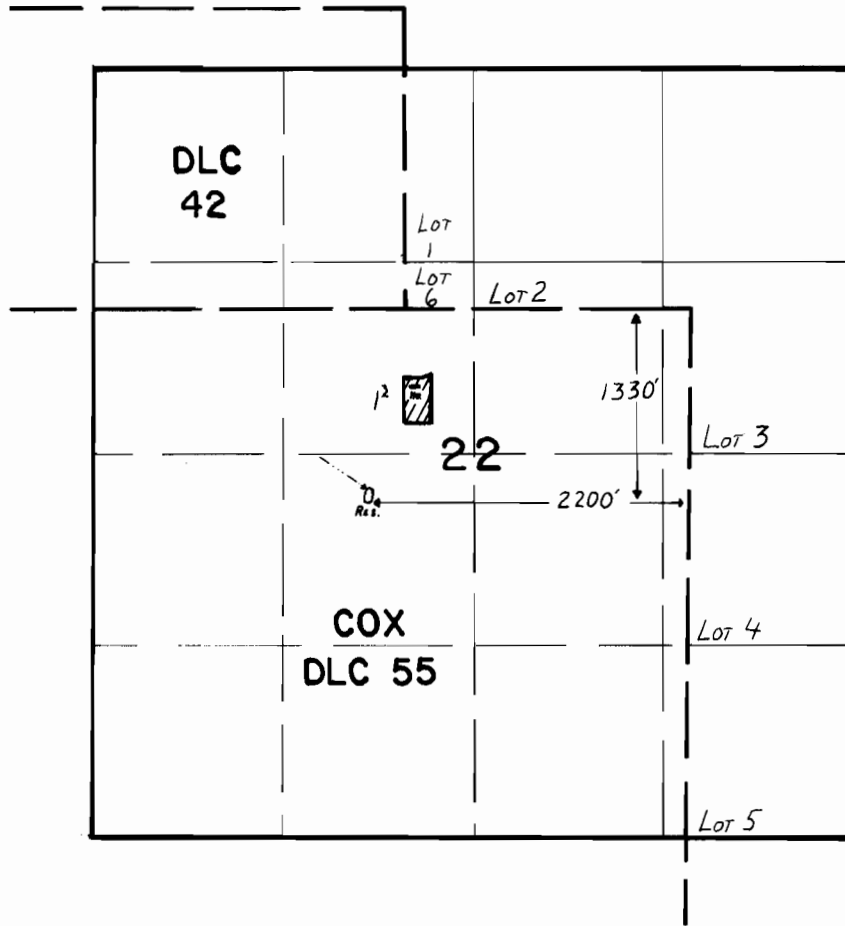

1" = 1320'

FINAL PROOF SURVEY UNDER

R-68282 R-10480
 Application No. 68283... Permit No. 49349.....
 IN NAME OF

.....DALE WERTZ.....

Surveyed MAR. 23.. 1988., by T.M. WARREN.....