


POLK COUNTY

SCALE 1" = 400'

SEE MAP NO 6 6 15

Application No. R-68282
Permit No. R10480 68283
49349

- 6. 1200 ft. South of South east corner Jacob Cox DLC #42
- 5. Land Irrigated 3 Acres
- 4. Pipeline
- 2. Direction of run-off water
- 1. Point of diversion
- 3. Dam
- 7. 50 ft. West of Southeast corner Jacob Cox DLC #42

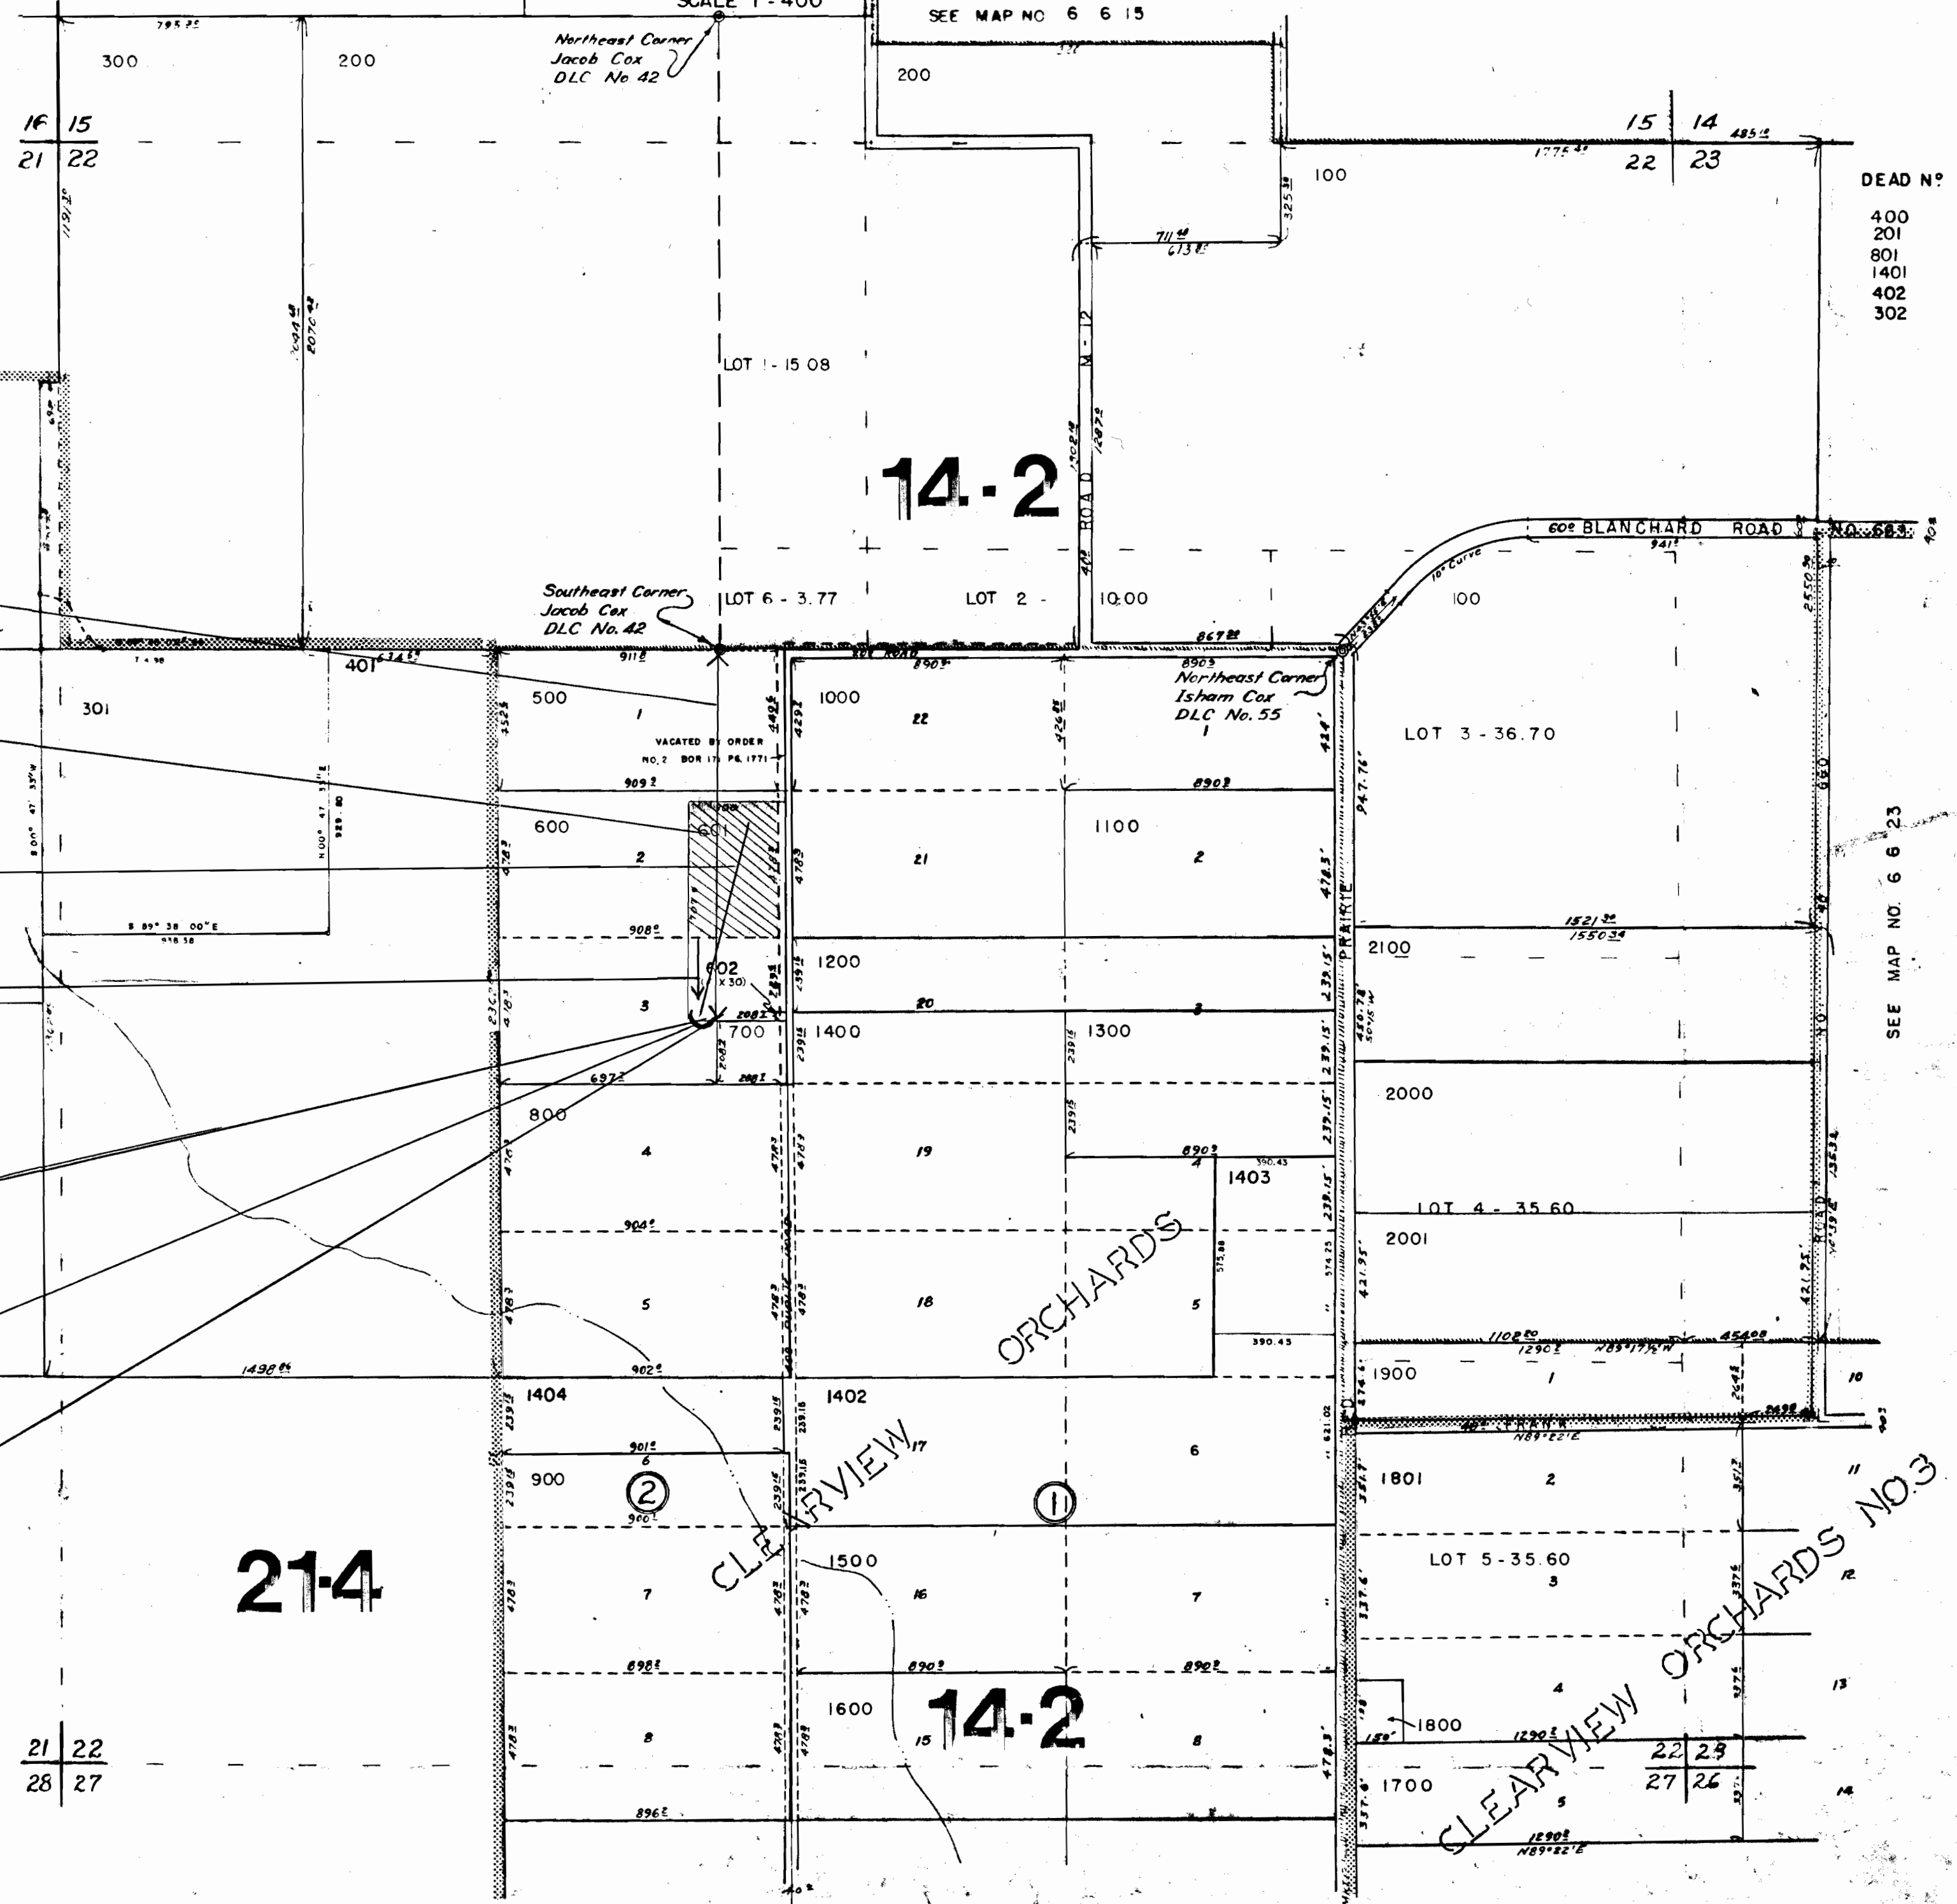

21-4

14-2

14-2