


P-40179  
60362

# T.14S., R.31E., W.M.

## SECTION II

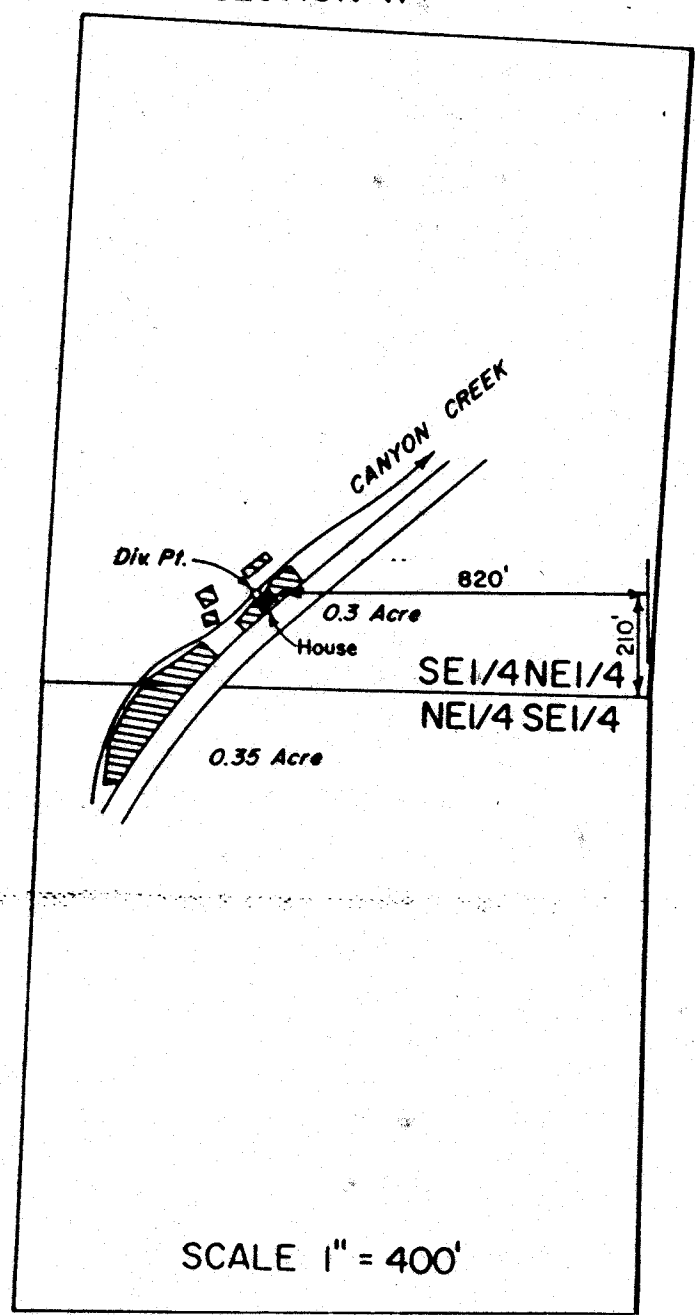

• **FINAL PROOF SURVEY**  
UNDER

Application No. 53825 Permit No. 40179  
IN NAME OF

**NEAL K. & HANNAH E. OWEN**

Surveyed SEPT. 30, 1981, by *MB Brown*