


T.35 S., R.4 W., W.M.

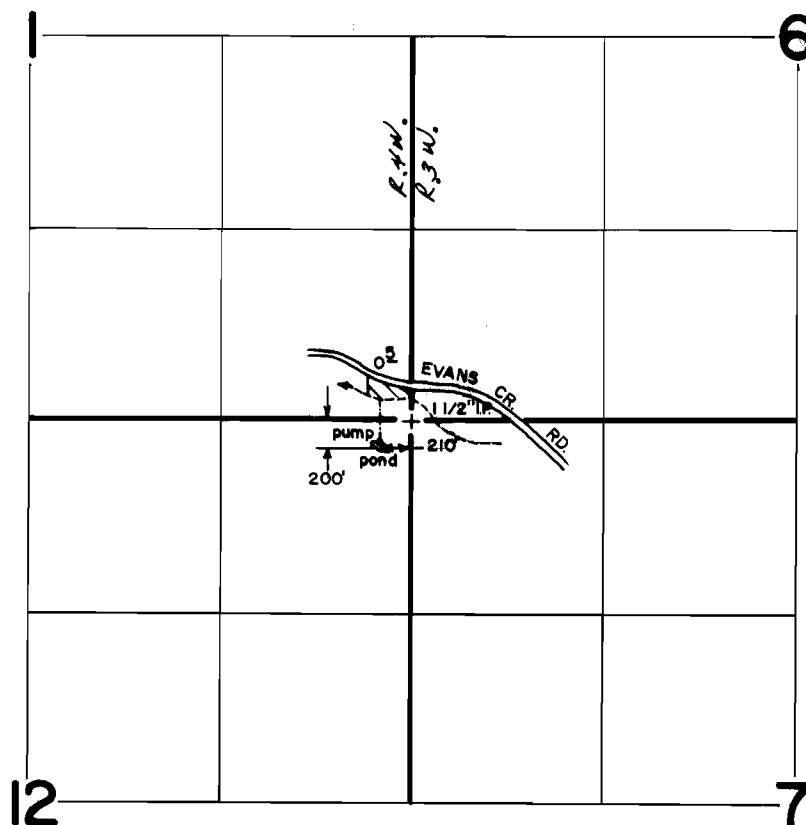

FINAL PROOF SURVEY
UNDER

Application No. 56174 Permit No. 42429...
IN NAME OF

OTTO &/or CLARA JOHNSON

Surveyed DEC. 13, 1983, by B. S. JAMES

SCALE: 4" = 1 MILE