
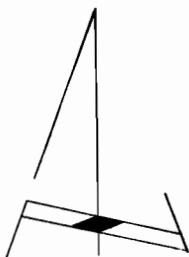


T. 8S., R. 38E., W. M.

SCALE 1" = 400

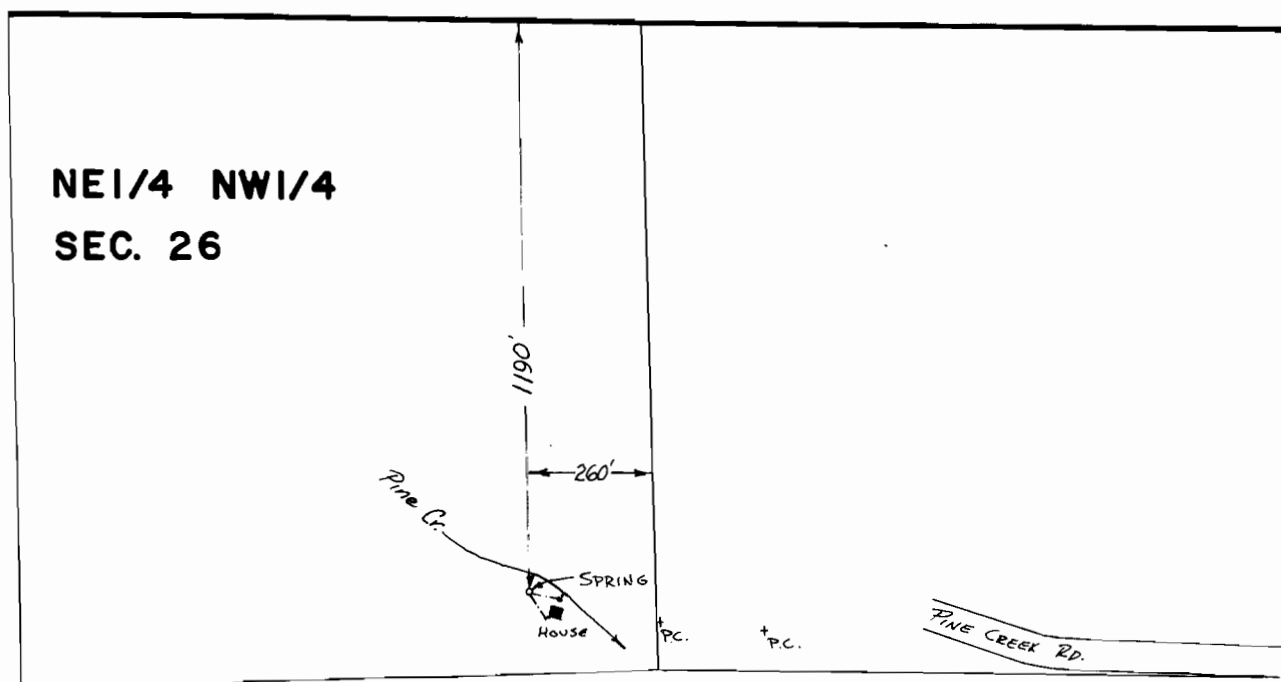

FINAL PROOF SURVEY
UNDER

Application No. **57338** Permit No. **43152**
IN NAME OF

HERMAN A. NELSON

Surveyed 4-15-1987, by V.L. Church