


# T.26S.,R.6W.,W.M.

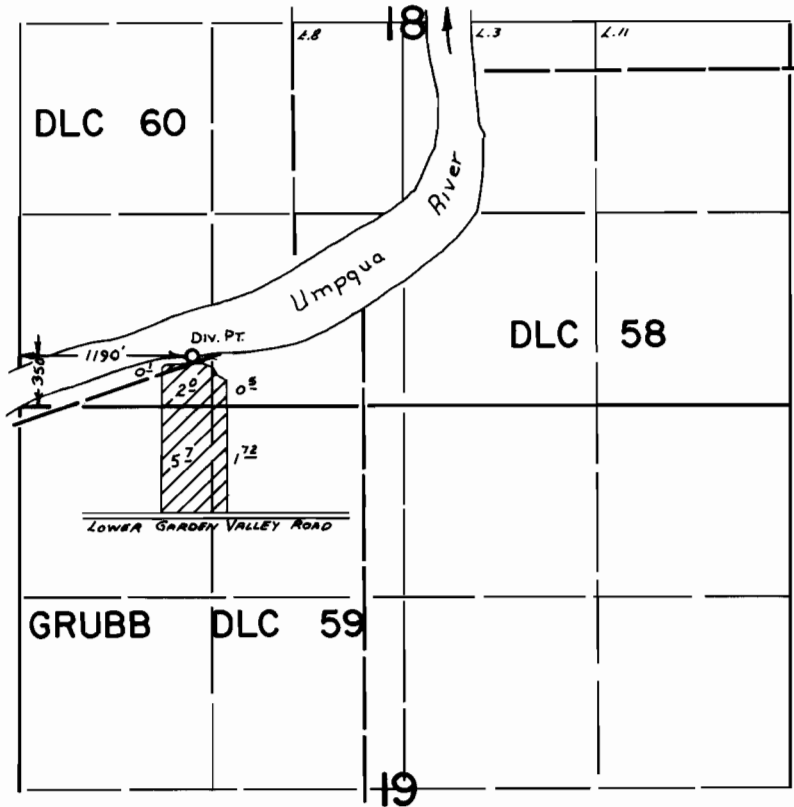

## FINAL PROOF SURVEY UNDER

Application No. .58900.. Permit No. ...44438....  
IN NAME OF

.....GEORGE L. & GLORIA J. BURT.....

Surveyed July 21.... 1982., by L.M. TOLL.....