


T. 16 S., R. 2 W., WM.

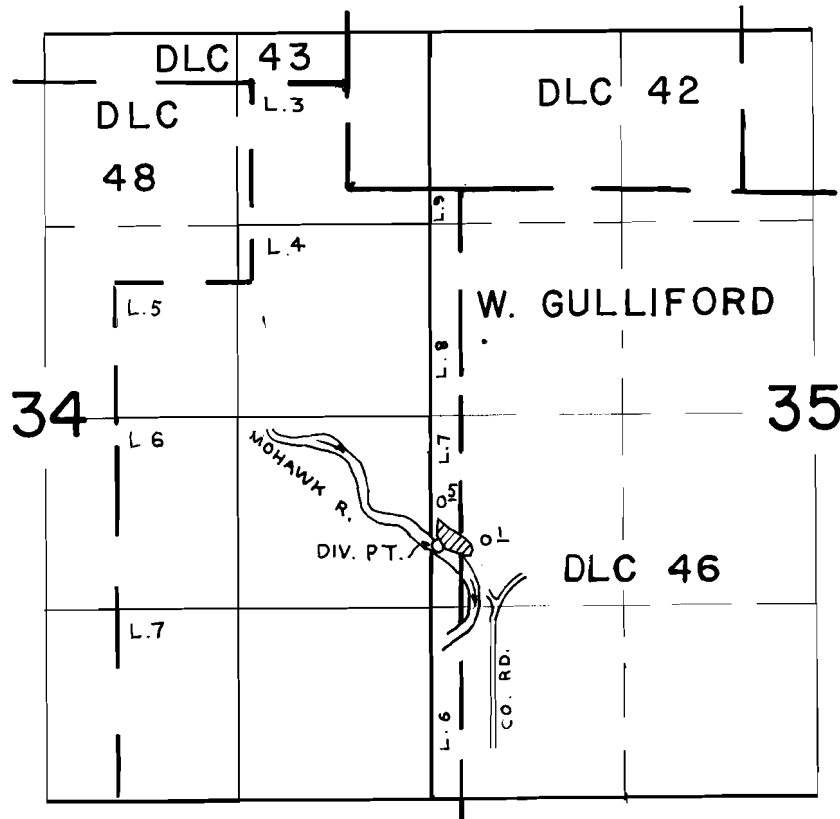

SCALE
1" = 1320'

DIV. PT. LOC. 1750' N. & 60' E. OF SW. COR. SEC 35

FINAL PROOF SURVEY UNDER

Application No. 58705 Permit No. 44796
IN NAME OF

ROE H. HATLEN

Surveyed JUL 19, 1984, by P. PAGTER