


T.38S., R.5W., W.M.

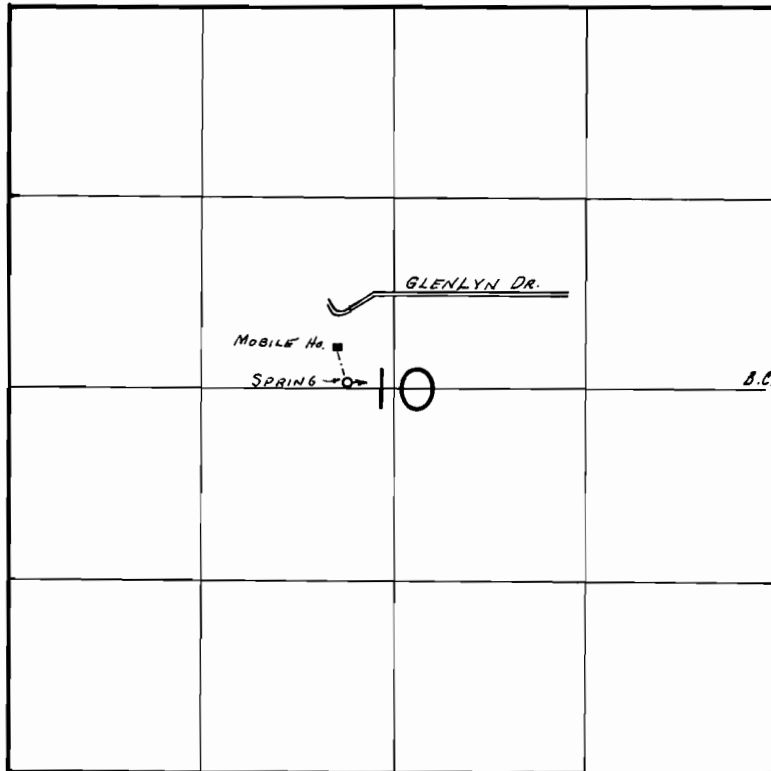

SPRING LOC.: 30' N. & 2960' W. FROM E. 1/4 COR. SEC. 10.

SCALE: 1" = 1320'

FINAL PROOF SURVEY UNDER

Application No. 60.11.3... Permit No. 46363....
IN NAME OF

.....GERALDINE A. WILLIAMS.....

Surveyed Sept. 16... 19.85, by B.S. JAMES.....