


# T3N, R10W, WM

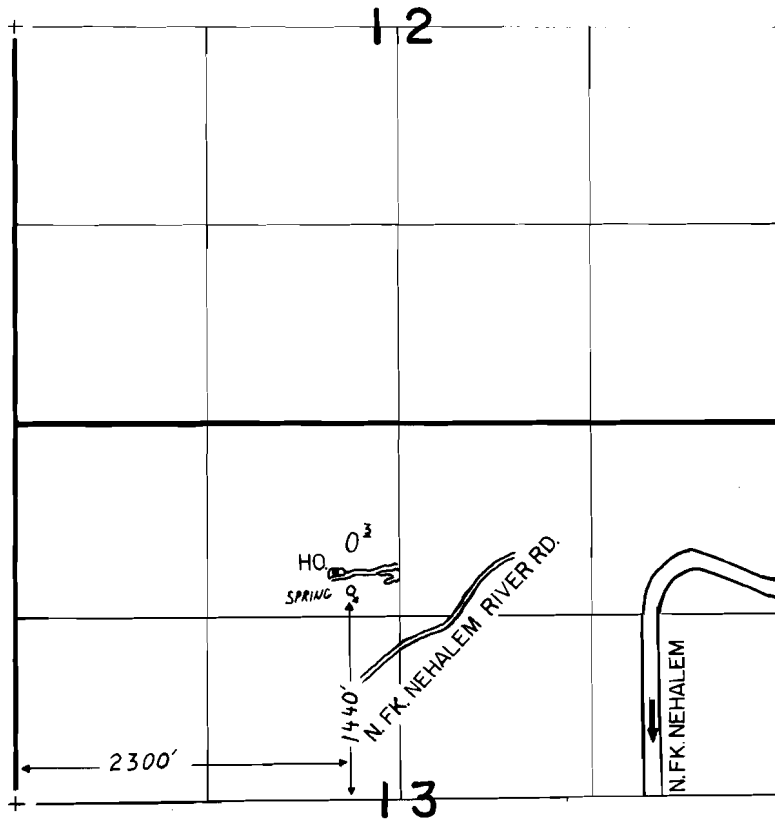

1" = 1320'

## FINAL PROOF SURVEY UNDER

Application No. 63311 Permit No. 46743  
IN NAME OF

.....GLEN W. & BETTY POWERS.....

Surveyed JULY 6 1987, by T.M. WARREN.....