

Application No. 64563


Permit No. 47293

RECEIVED

DEC- 2 1982

WATER RESOURCES DEPT.
SALEM, OREGON

T.6S.,R.7W.,W.M.

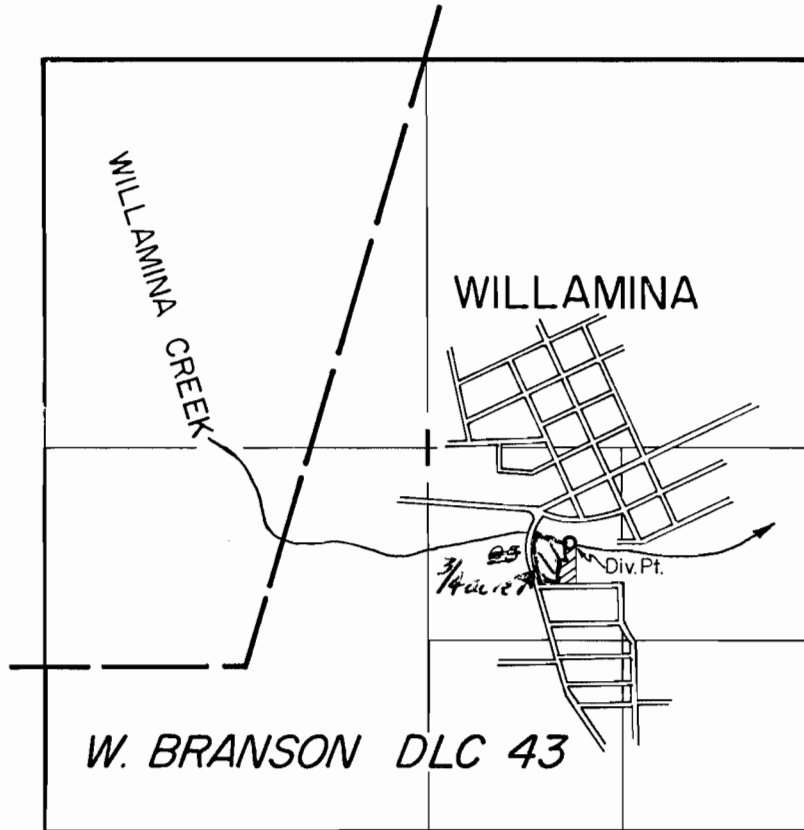

UEP
12/2/82

DIV. PT. LOC: 1980' N. & 1680' W., from the SE corner Section 1

~~FINAL PROOF SURVEY~~

UNDER

~~Application No. 52953 Permit No. 39976~~

IN NAME OF

~~WILBER M. SIMS~~

Surveyed ~~JUNE 1~~ 19.79, by ~~[Signature]~~