

Application No. 59446

Permit No. 44678


RECEIVED

Robert D. Summers
35, R 4 W 1/4. Tax lot 234-1-3
Yamhill Ore. 97148

Application No. 65072
Permit No. 47607

WATER RESOURCES DEPT.
SALEM, OREGON

PROPOSED LOCATION
OF HOUSE

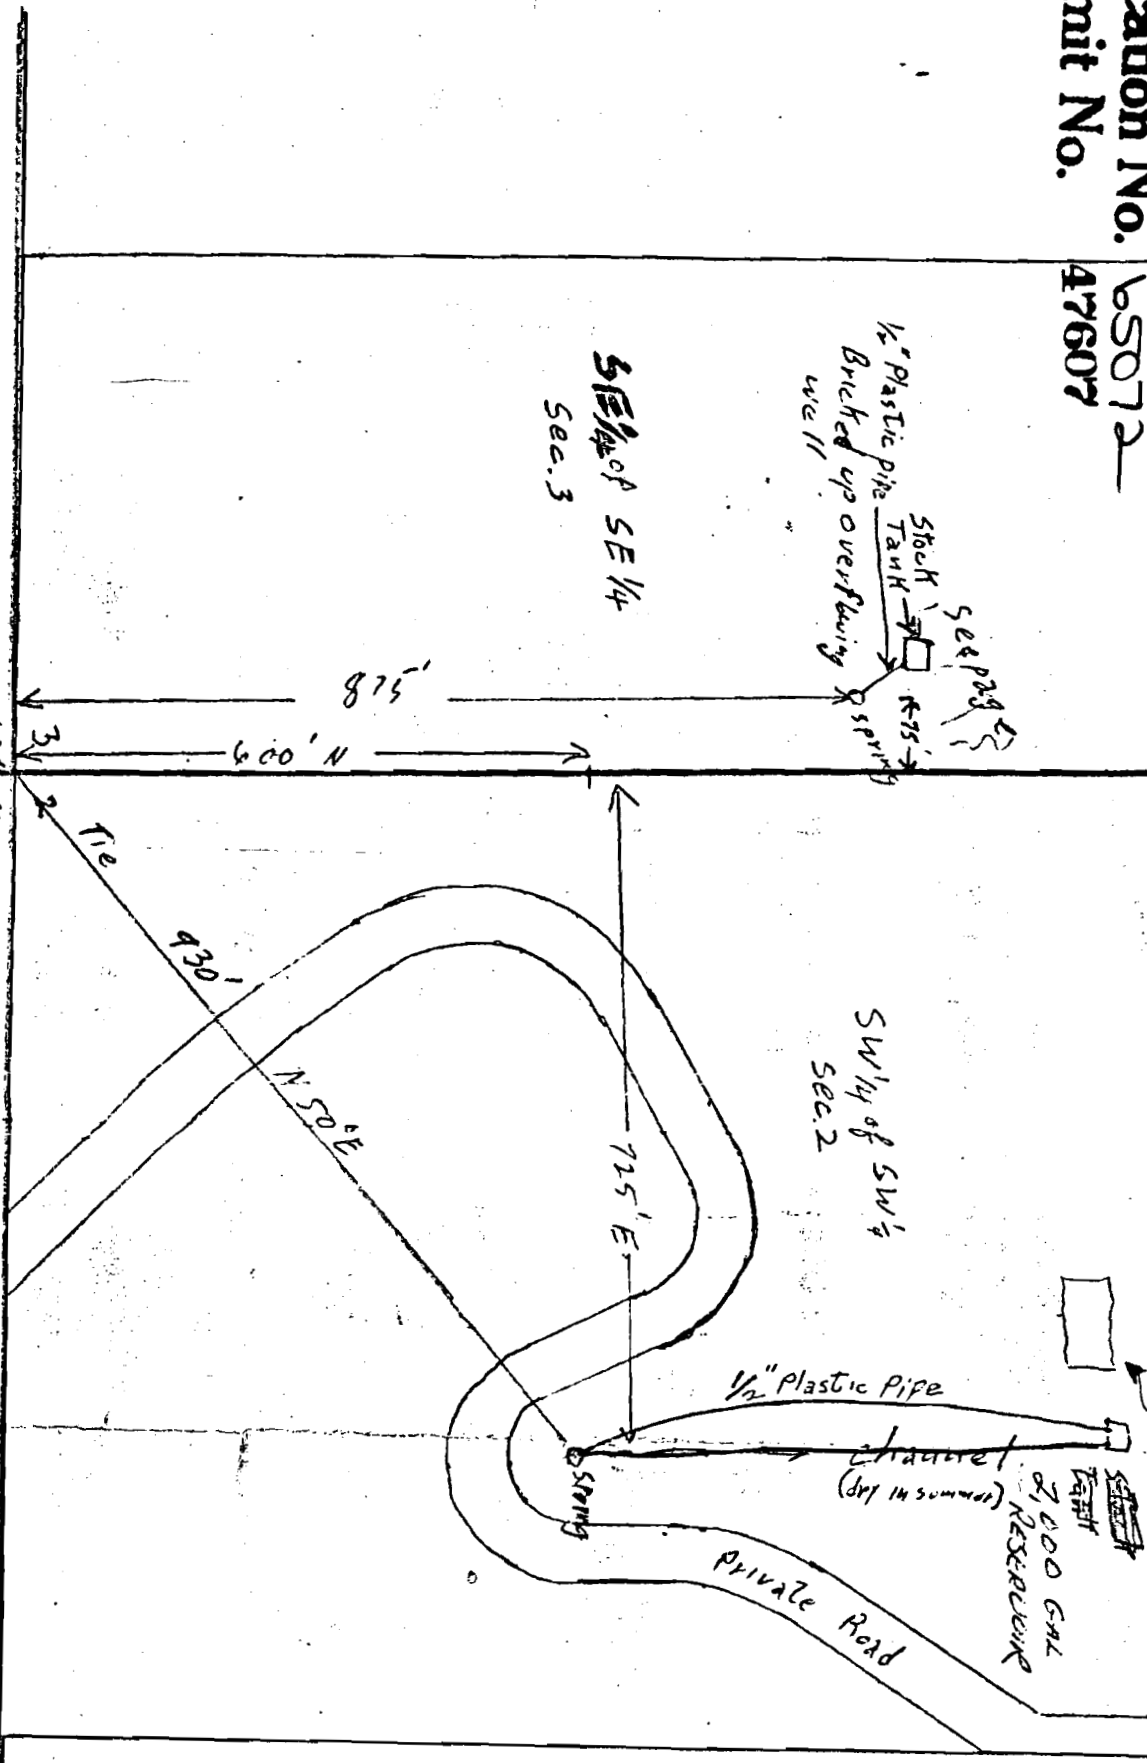

SE 1/4 of SE 1/4
Sec. 3

See page 5
Stock Tank
1/2\" Plastic Pipe
Bridged up overflowing
well

SW 1/4 of SW 1/4
Sec. 2

2,000 GAL
RESERVOIR

RECEIVED

FEB 10 1975

Section
Corner

Application No. 52772

90044