


T. 2 N., R. 12 E., W.M.

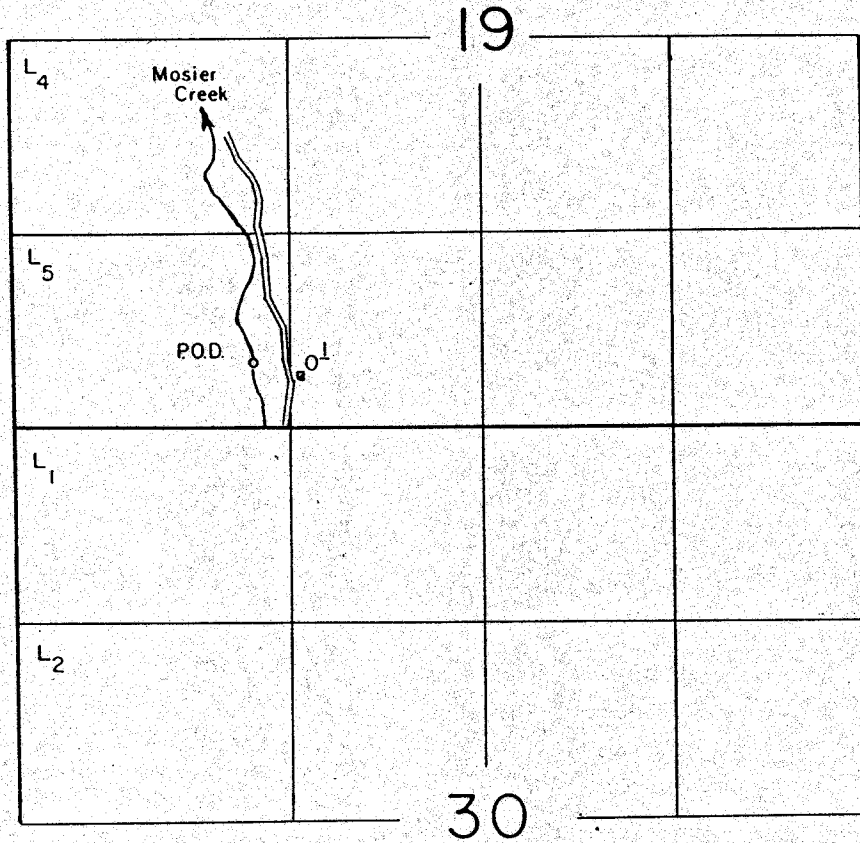

P.O.D. Loc. : 450' N. & 280' W. from SE Cor. Lot 5 (SW 1/4 SW 1/4) Sec. 19

Scale : 1" = 1320'

FINAL PROOF SURVEY
UNDER

Application No. 65227 Permit No. 48095
IN NAME OF

LETICIA GRAW

Surveyed April 12, 1988, by J. Warren

41065-379-19L
10/17/80 TMW