


T6S, R8W, WM

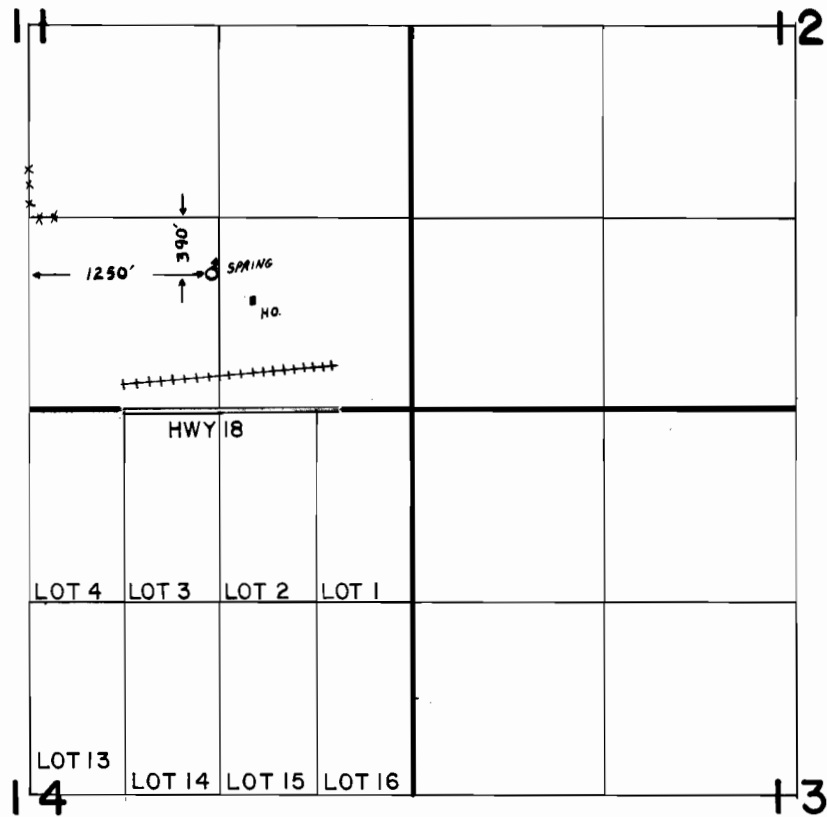

FINAL PROOF SURVEY UNDER

Application No. 68255 Permit No. 49191
IN NAME OF

BARBARA A. SHELBOURN

Surveyed APRIL 21 1987, by B.W. BISHOP