


T3N, R10W, WM

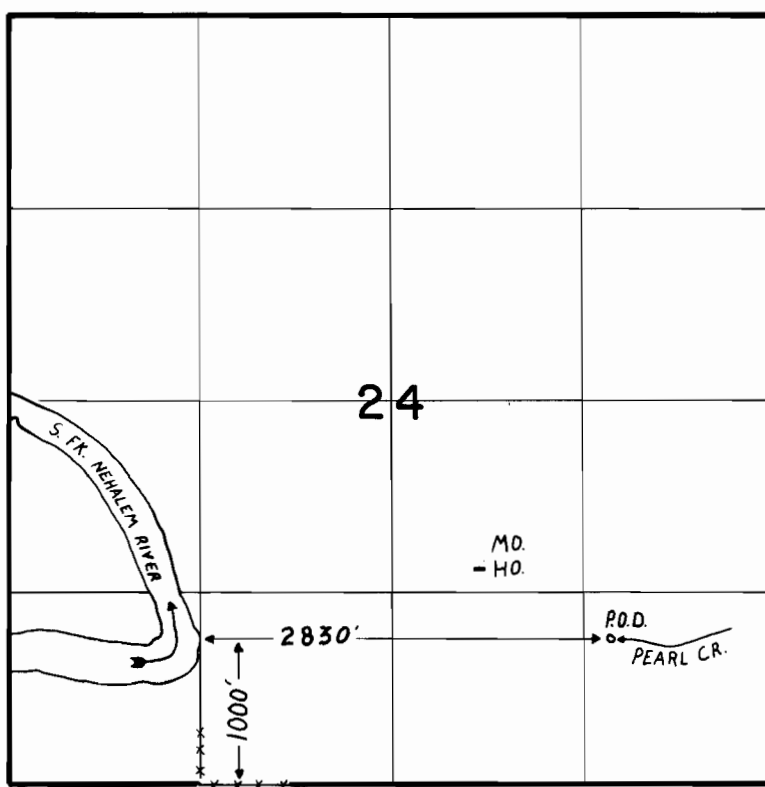

N
1" = 1320'

FINAL PROOF SURVEY UNDER

Application No. 68305.. Permit No. 49272....

IN NAME OF

DAN D. & MARIE McCOY &
HOWARD & IRENE JUDD

Surveyed JULY...7.. 1987, by T.M. WARREN....