


T 10S, R 5W, WM

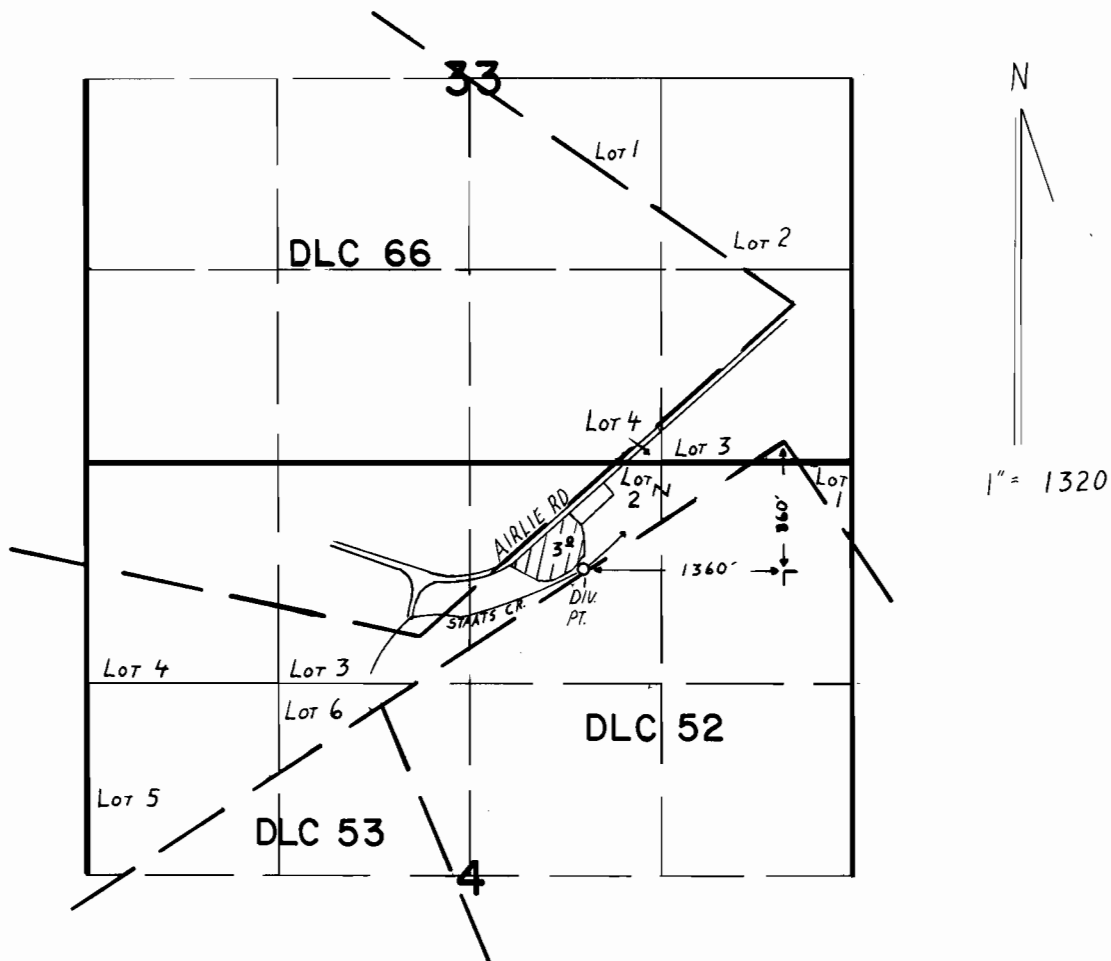

FINAL PROOF SURVEY UNDER

Application No. ~~68369~~ Permit No. ~~49407~~.....
IN NAME OF

.....DONALD M. BURCH.....

Surveyed JUNE...4.. 1987., by B.W. BISHOP.....