


T3N, R9W, WM

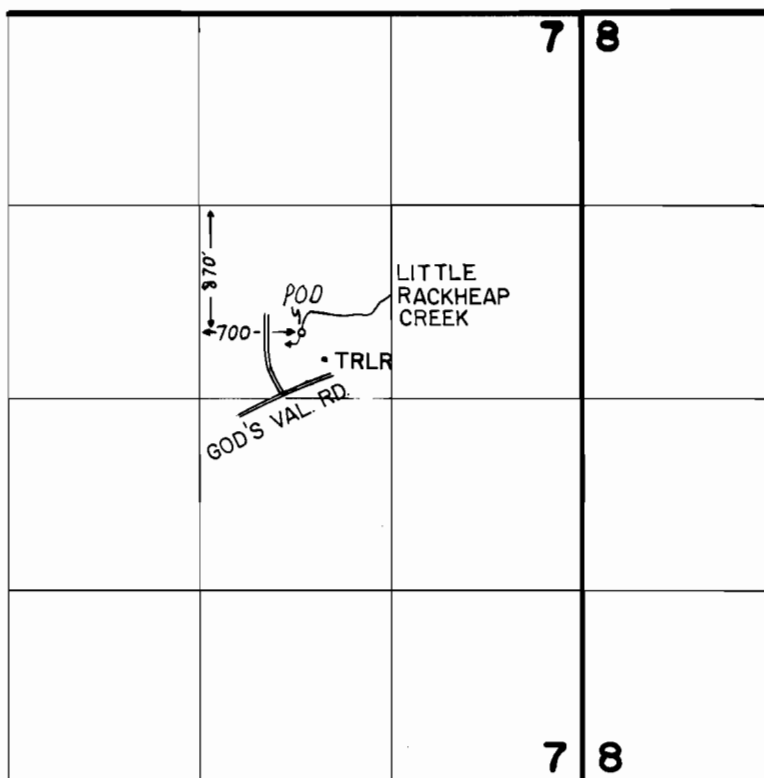

1" = 1320

FINAL PROOF SURVEY UNDER

Application No. 68613 Permit No. 49620
IN NAME OF

GLENNA GENE PARKER

Surveyed JULY 7 1987, by T.M. WARREN