
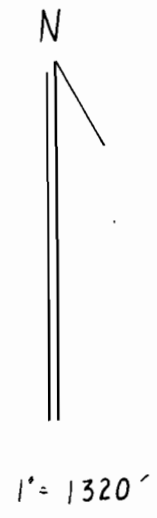


T 6S, R 4W, WM

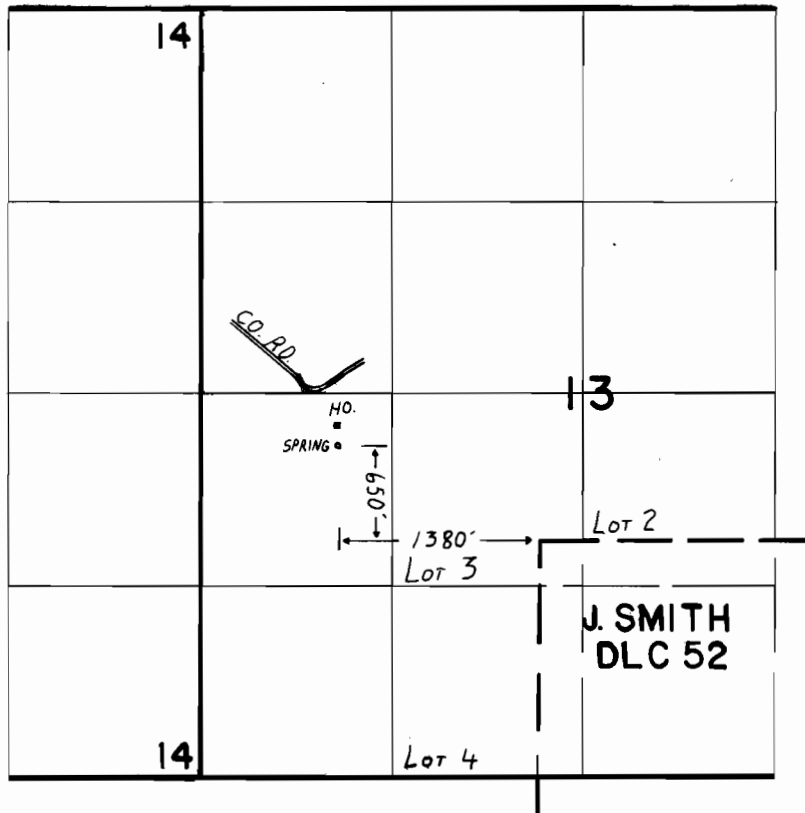

FINAL PROOF SURVEY UNDER

Application No. 68961 Permit No. 49883
IN NAME OF

GEORGE & CLARA SCHROEDER

Surveyed APRIL 29 1987., by B.W. BISHOP