


SECTION 06 T.40S. R.08E. W.M.
KLAMATH COUNTY

40 08 06
& INDEX

1"=400'

THIS MAP WAS PREPARED FOR
ASSESSMENT PURPOSE ONLY.

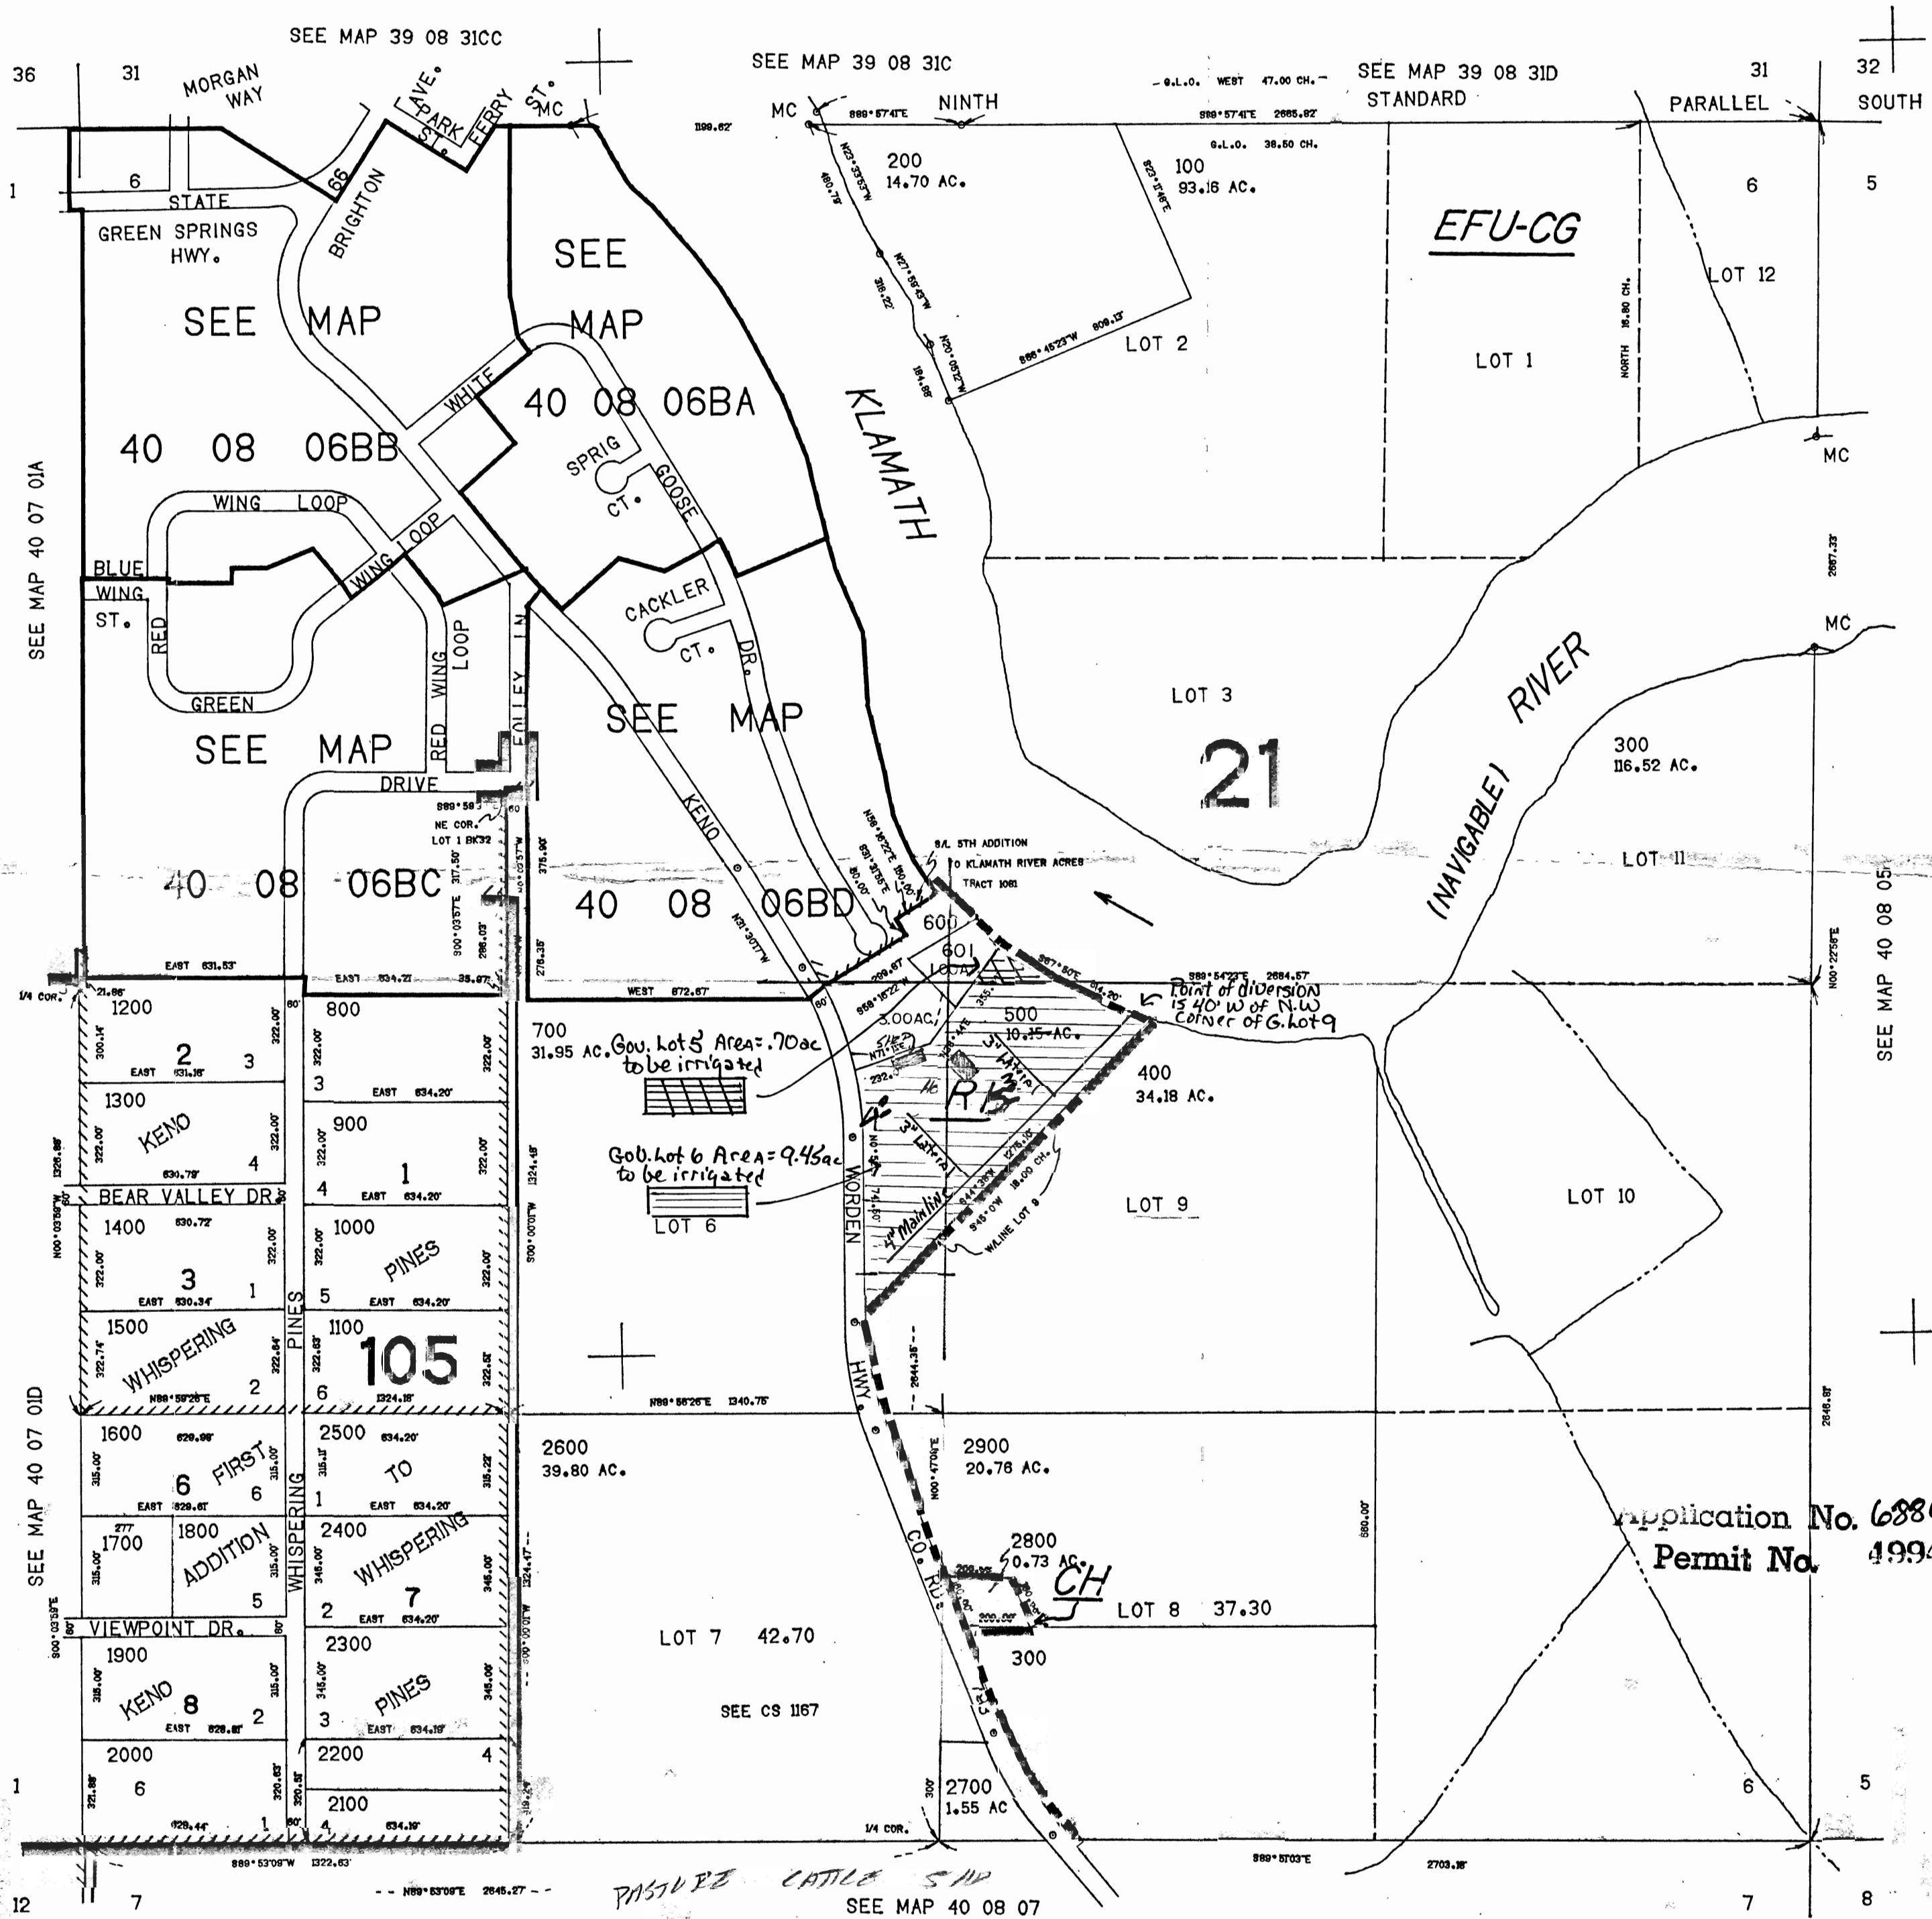

RECEIVED
OCT 15 1986
WATER RESOURCES DEPT.
SALEM, OREGON

Application No. 68862
Permit No. 49941

40 08 06
& INDEX

000191