


T.4S.R.39E.W.M.

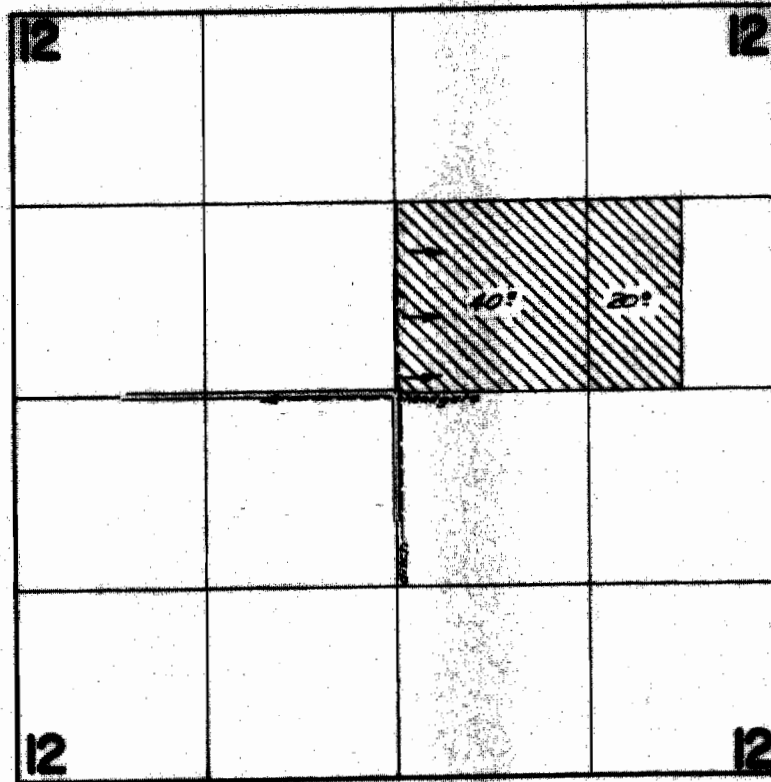

*Note: diversion point is located
770 feet North and 470 feet West
from S.E. Corner Section 13*

FINAL PROOF SURVEY UNDER

Application No. 37032... Permit No. 26795...
IN NAME OF

CARL G. HELM, JR.

Surveyed Sept. 25 1963, by C. R. Baker.