5- Lebanek
25313

T.4S. R.14E. W.M.

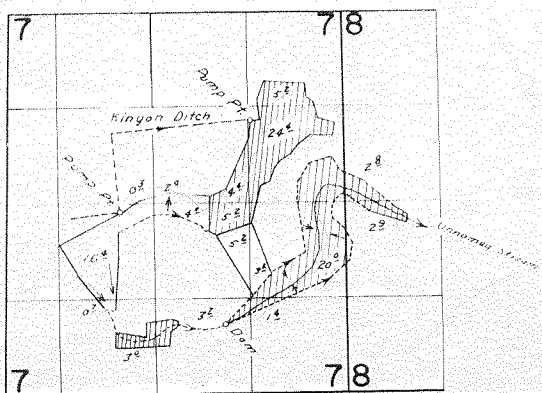

Diversion Point from White River. NW1/4NW1/4 Section 12
T. 4S. R.13E. W.M.

FINAL PROOF SURVEY
UNDER

Application No. 32000 Permit No. 25313
IN NAME OF

FRED L. and MAXINE A. ASHLEY

Surveyed Oct. 22, 1964., by C.J. Gardner

1964-0