T. 36 S., R. 1 W., W.M.

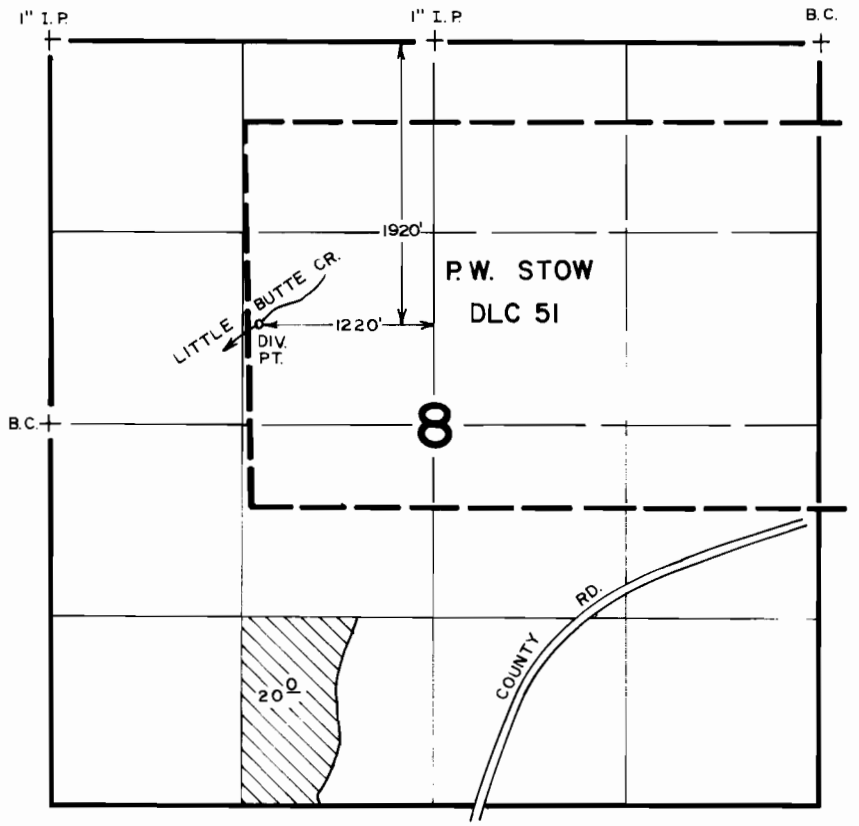

FINAL PROOF SURVEY

UNDER

TRANSFER NO. 3602

Application No. ..... Permit No. .....

IN NAME OF

JOHN KENDLE

Surveyed MAY 4 19 83, by B.S. JAMES

SCALE: 4" = 1 MILE

PTS-1978-14-C
BAX-3AA-56 TWB