


T. 5 S., R. 4 W., W.M.

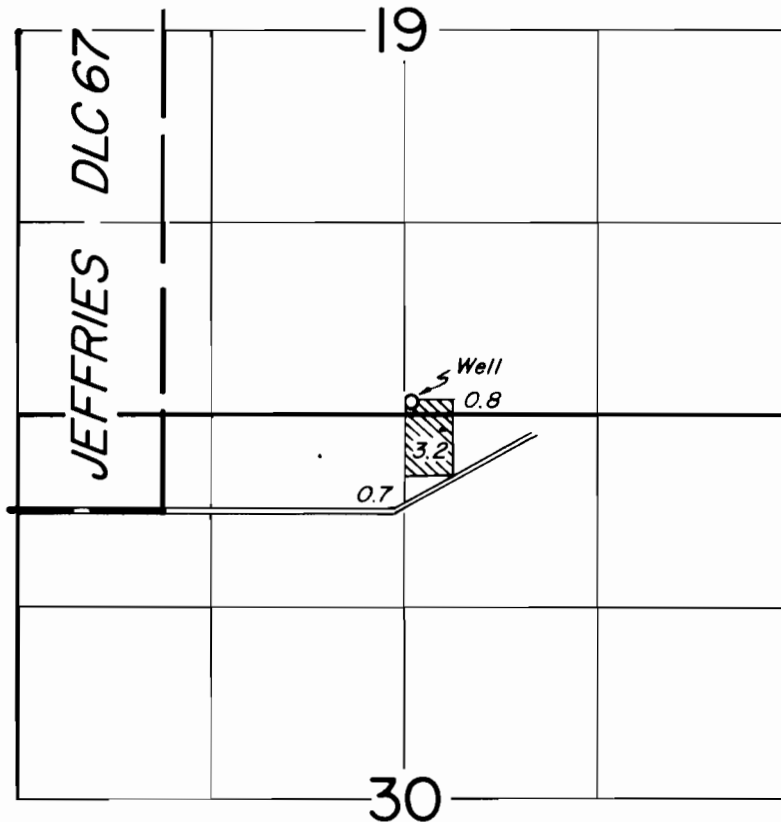

WELL: 90' NORTH & 50' EAST FROM 3/4 COR
SECTION 19

FINAL PROOF SURVEY UNDER

Application No. G-5871. Permit No. G-5211.....
IN NAME OF

REBEL EVETTE MARTIN

Surveyed MAY 31, 1979, by *dlb*.....