


T. 21S., R. 38E., W. M.

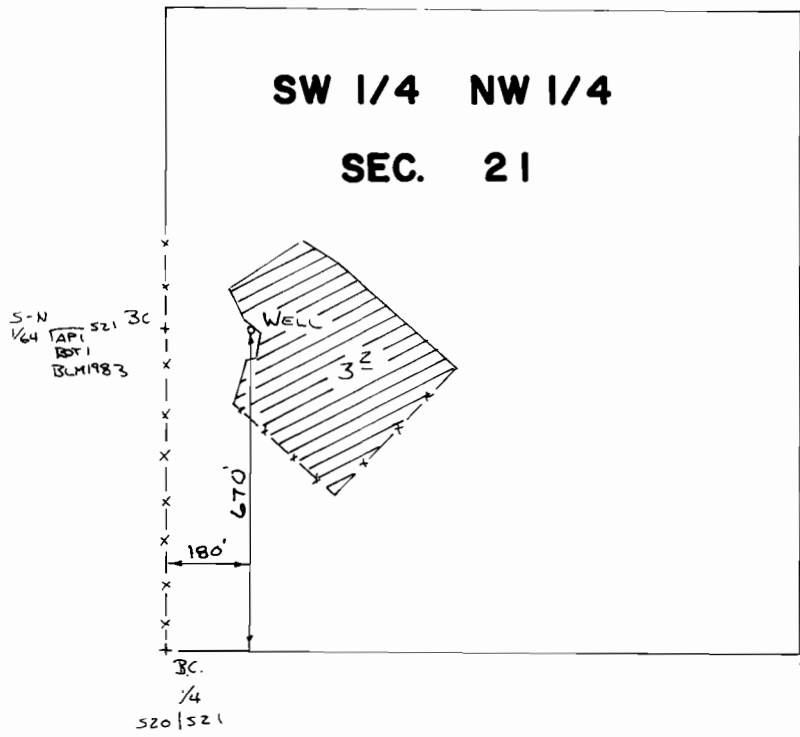

SCALE 1" = 400'

FINAL PROOF SURVEY
UNDER

Application No. **G-7139** Permit No. **G-6589**
IN NAME OF

JOHN W. WHARTON

Surveyed 10-12 1988, by V.L. Church

PTS

V.L.C.