


T. 35 S., R. 3 W., W. M.

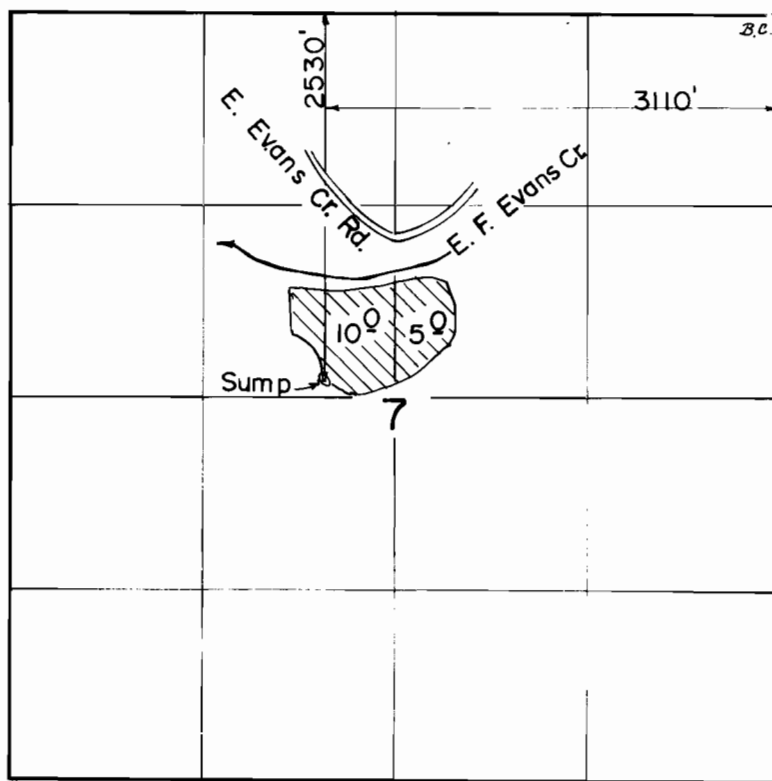

Scale: 1" = 1320'

FINAL PROOF SURVEY
UNDER

Application No. G-7958 Permit No. G-7335
IN NAME OF

..... HAROLD A. ANDERSON

Surveyed JUN. 10. 1987., by B. S. JAMES.....