


T. 5S., R. 2W., W.M.

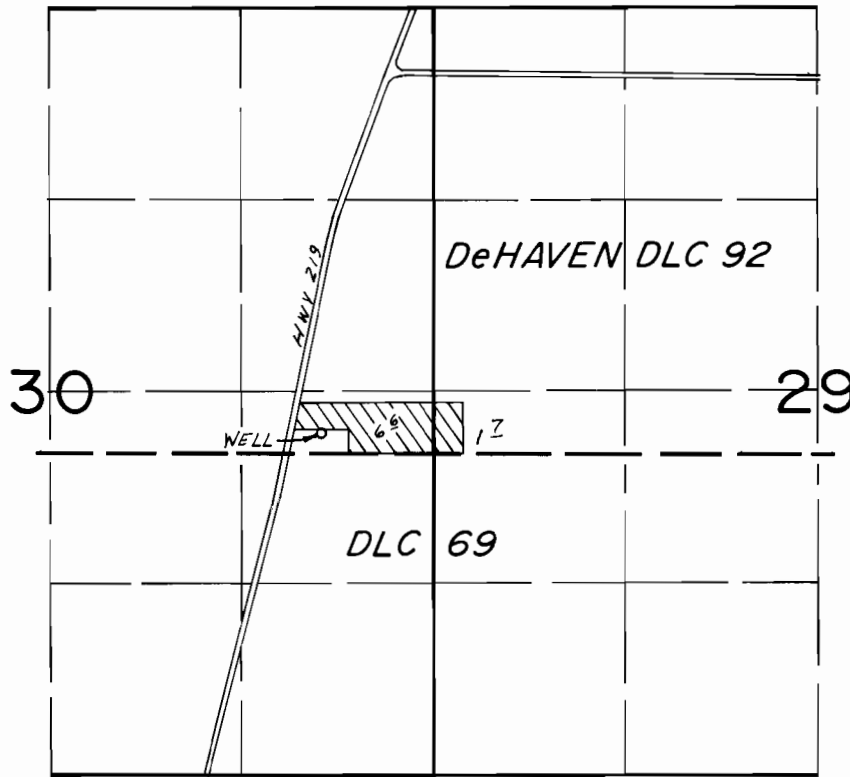

WELL LOC: 290'S. & 770'W. FROM E. 1/4 COR. SEC. 30

FINAL PROOF SURVEY

UNDER

Application No. G-8248 Permit No. G-7674.....

IN NAME OF

DVA

Surveyed OCT. 5..... 1983, by L.M. TOLL.....