


T. 40 S., R. 7 W., W.M.

HOLLAND LOOP ROAD

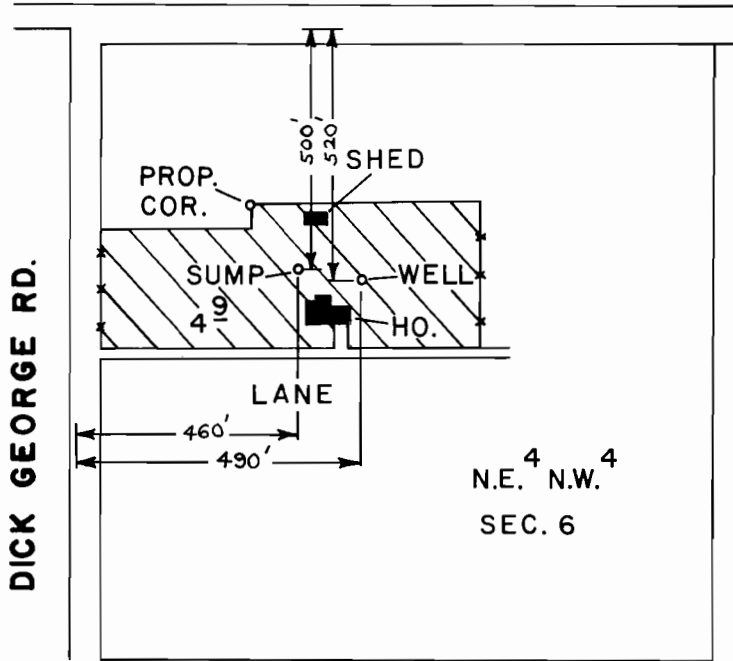

SCALE: 1" = 400 FT.

FINAL PROOF SURVEY UNDER

Application No. G-8388 Permit No. G-8062
IN NAME OF

DVA

Surveyed JUNE 12, 1979, by B. SUND

K.J.M.

P.T.S. - 1979-14-B