


T.15S., R.14E., W.M.

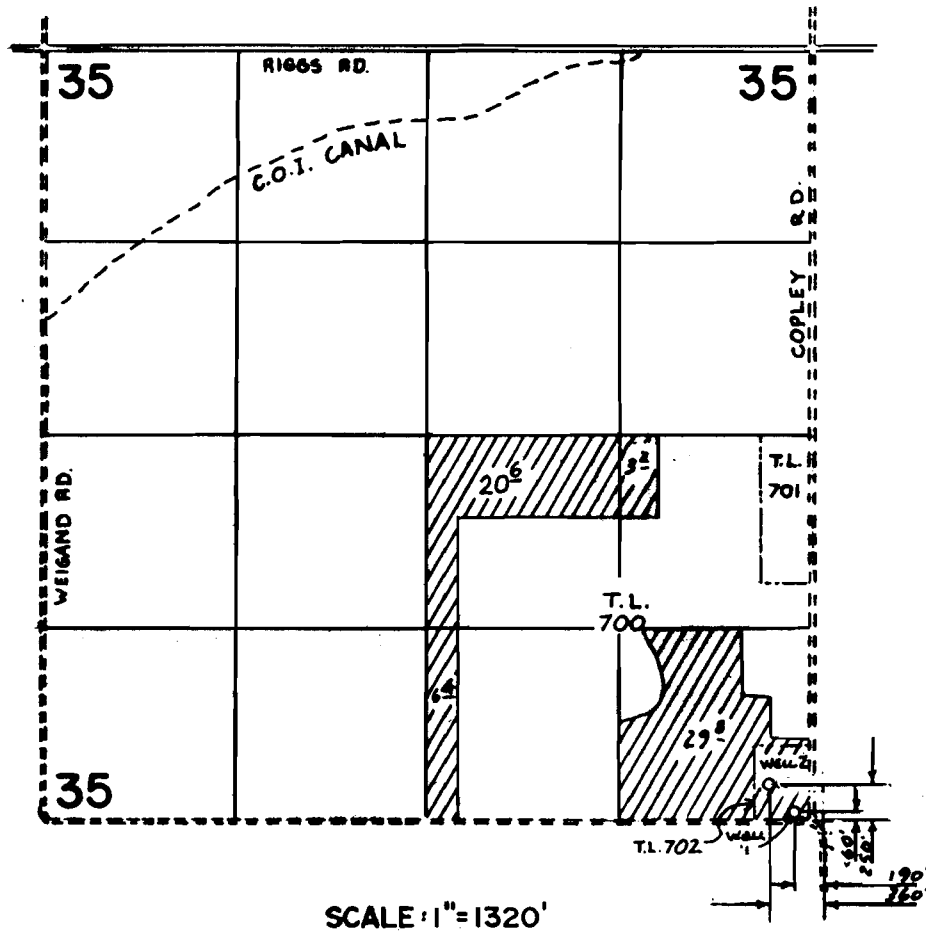

THIS CORNER
T.16S., R.14E.
2 | 1

SCALE: 1" = 1320'

FINAL PROOF SURVEY UNDER

Application No. G-8625 Permit No. G-7909

Cert. 60424

IN NAME OF

RODNEY S. JOHNSON

Surveyed APRIL 2, 1985, by LESLIE OLSON

RECEIVED

DATE 4-5-89

WATER MASTER DISTRICT #11

BY SM