


T.11S. R22E. W.M.

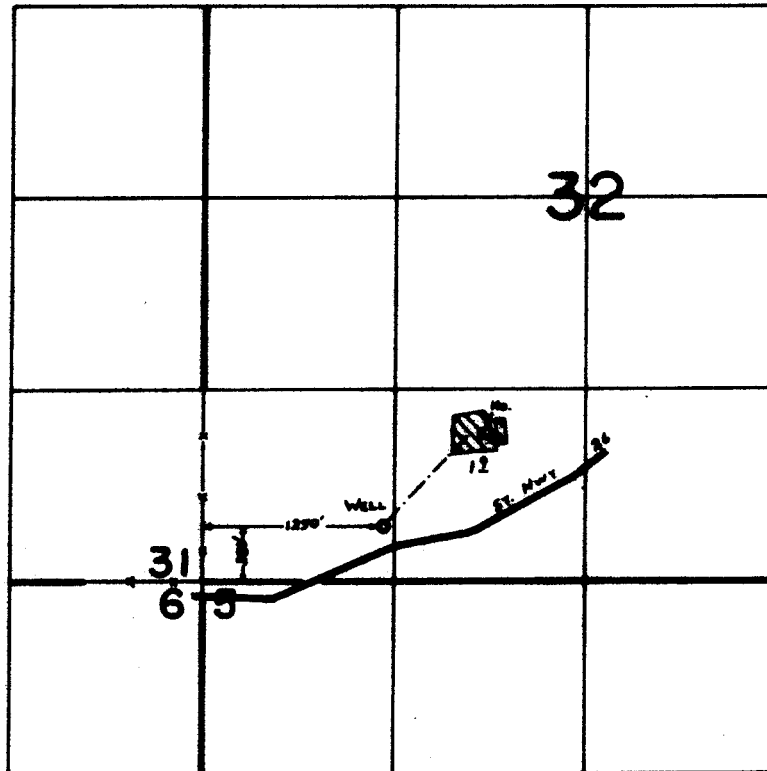

FINAL PROOF SURVEY
UNDER

Application No. G-8978 Permit No. G-8444...
IN NAME OF

CHARLES C. & CHLOIE MAXWELL

Surveyed July...24. 19.79, by C.L. HUGHES....