


T# 6-2311

Application No. G-9046  
Permit No. G 8397

# T4S R12E WM

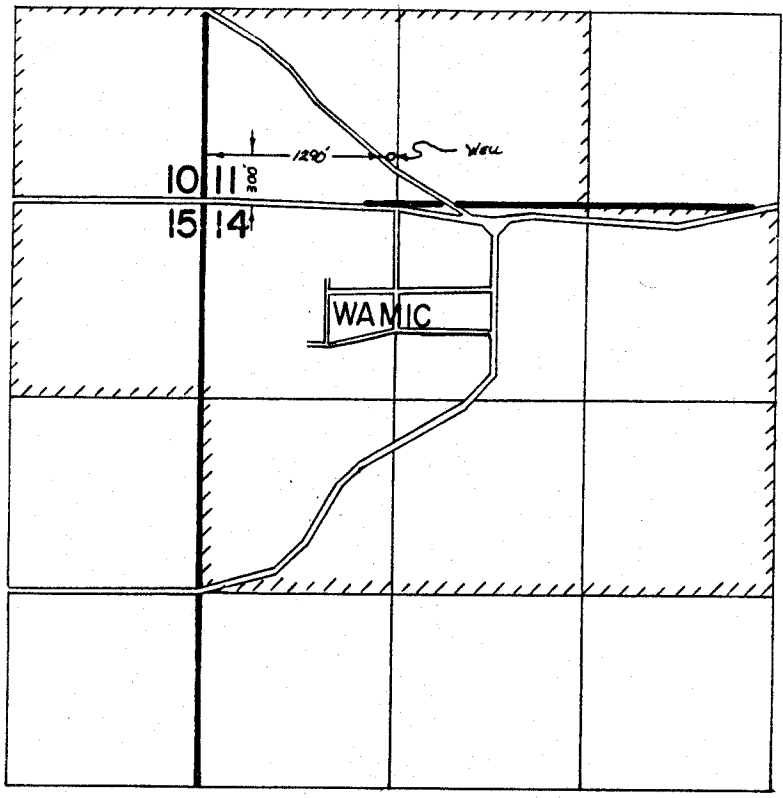

APPLICATION MAP FOR  
WAMIC COOPERATIVE WATER ASSOCIATION

SCALE 4" = 1 MILE

THIS MAP PREPARED BY:  
*[Signature]*  
FROM INFORMATION FURNISHED BY  
THE APPLICANT.