T.13S.,R.1W.,W.M.

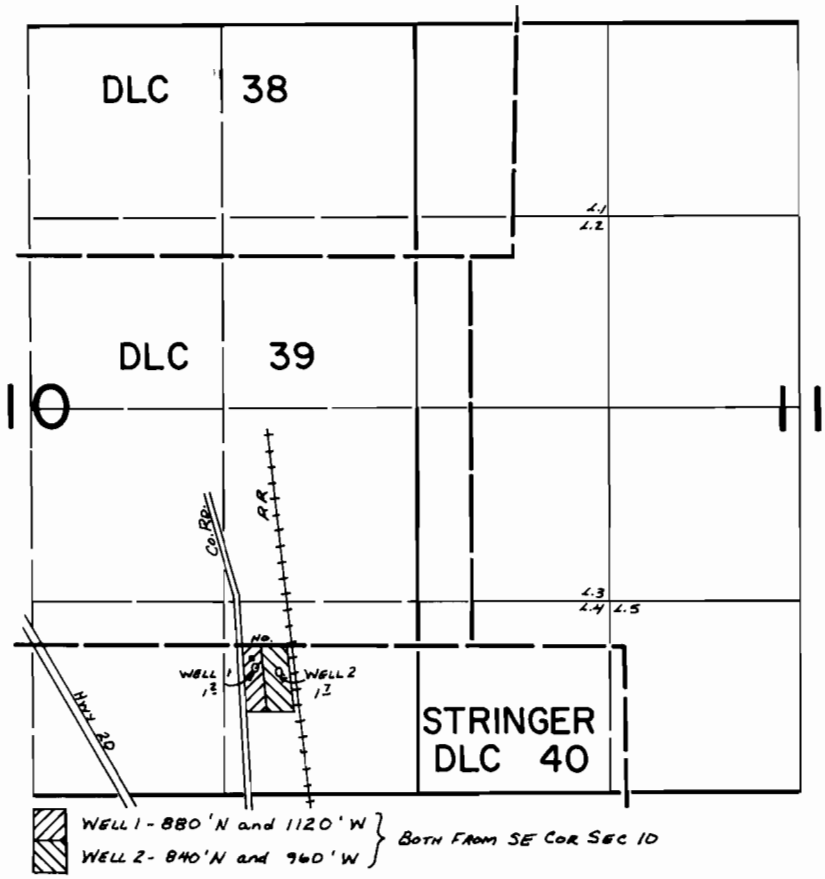

FINAL PROOF SURVEY

UNDER

Application No. G-9179 Permit No. G-8496

IN NAME OF

MR. & MRS. JOSEPH L. WILSON

Surveyed April 29 19.82, by L. M. TOLL

OFM-3LL-218