


Y-8512

60428

# T.39S.R.1E.W.M.

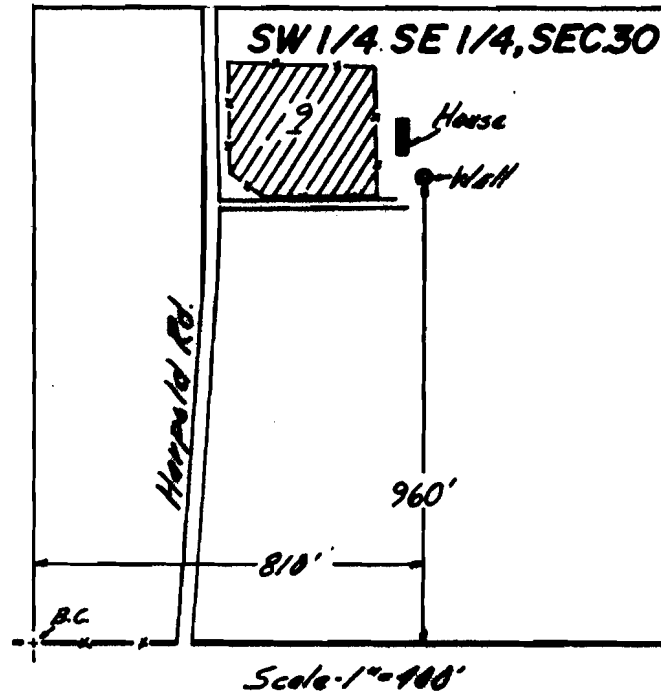

## FINAL PROOF SURVEY UNDER

Application No. G-9044 Permit No. G-8512.....  
IN NAME OF

.....ROBERT...T...SCHROEDER.....

Surveyed Sept..25. 1979., by C.R.RODRIGUEZ.