


T. 36 S., R. 2 W., W.M.

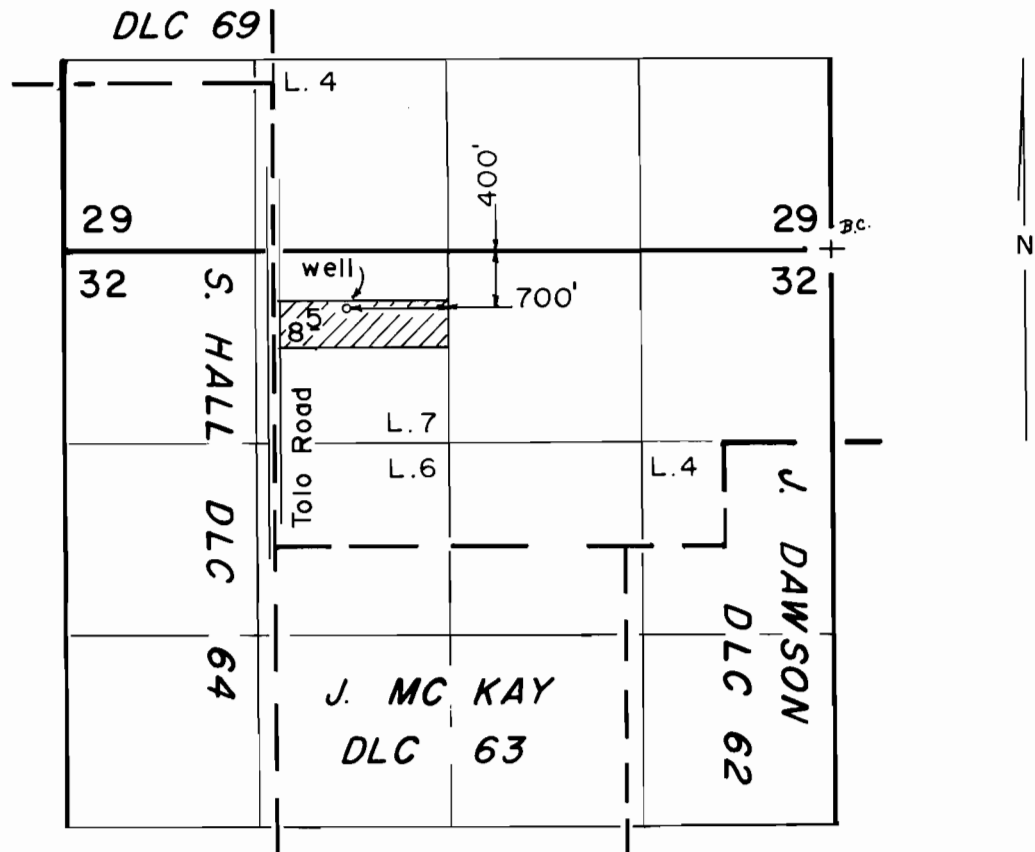

Scale: 1" = 1320'

FINAL PROOF SURVEY
UNDER

Application No. G-9155 Permit No. G-8516
IN NAME OF

MICHAEL WILLIAM BEDINGFIELD

Surveyed MAY 28 1986, by B. S. JAMES