


T. 6 & 7 S., R. 2 W., W.M.

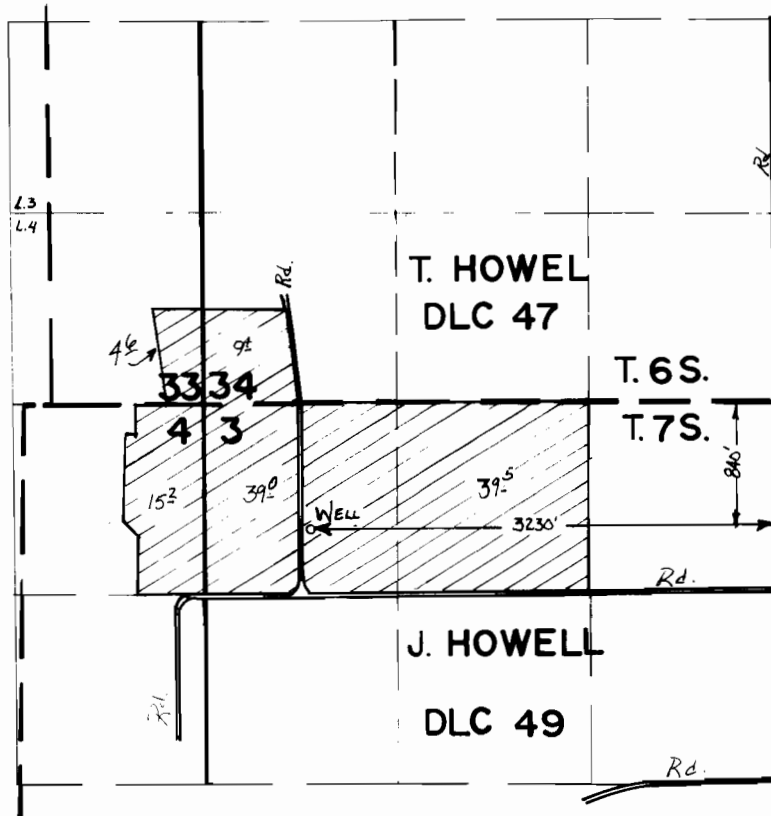

SCALE 4" = 1 MI

FINAL PROOF SURVEY UNDER

Application No. **G.9186**. Permit No. **G.8521**...
IN NAME OF

DONALD L. DUNIGAN & EDRA LUCILE PAVLIK

Surveyed **NOV. 14, 19.83.**, by **M. CAHILL**.....