
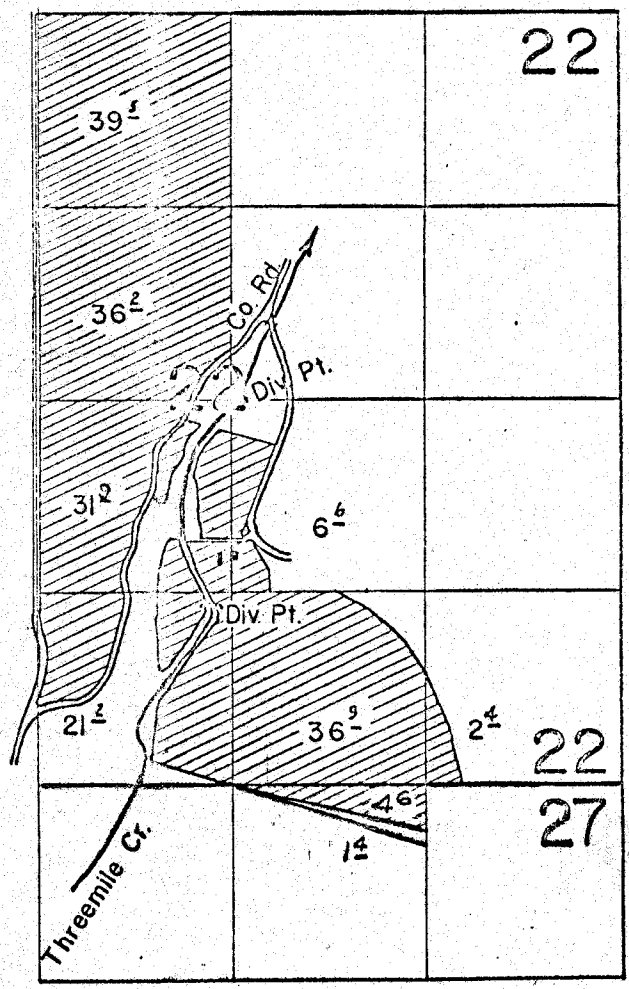


T. 1 N. R. 13 E. W.M.

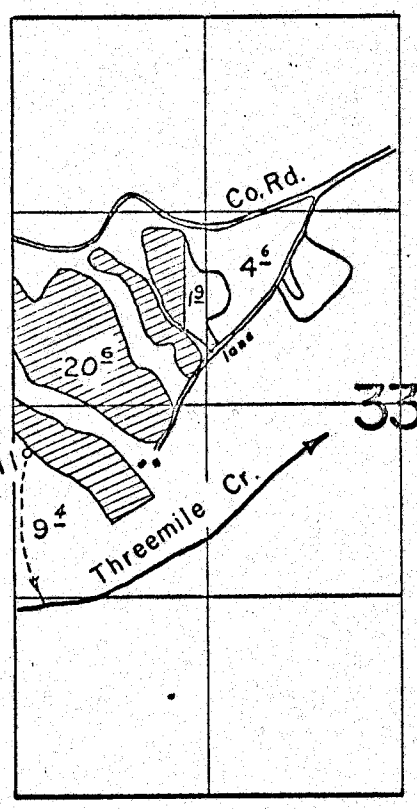

Application No. G-7916
 Permit No. G 8540

FINAL PROOF SURVEY
 UNDER

Application No. ~~6-1600~~ Permit No. ~~6-1466~~
 IN NAME OF

ROBERT E. & ARTHUR E. SANDERS

Surveyed April 8, 1963, by *Darryl F. Bousch*

RECEIVED
 MAR 11 1977
 WATER RESOURCES DEPT
 SALEM, OREGON