


T. 2 N., R. 3 W., W.M.

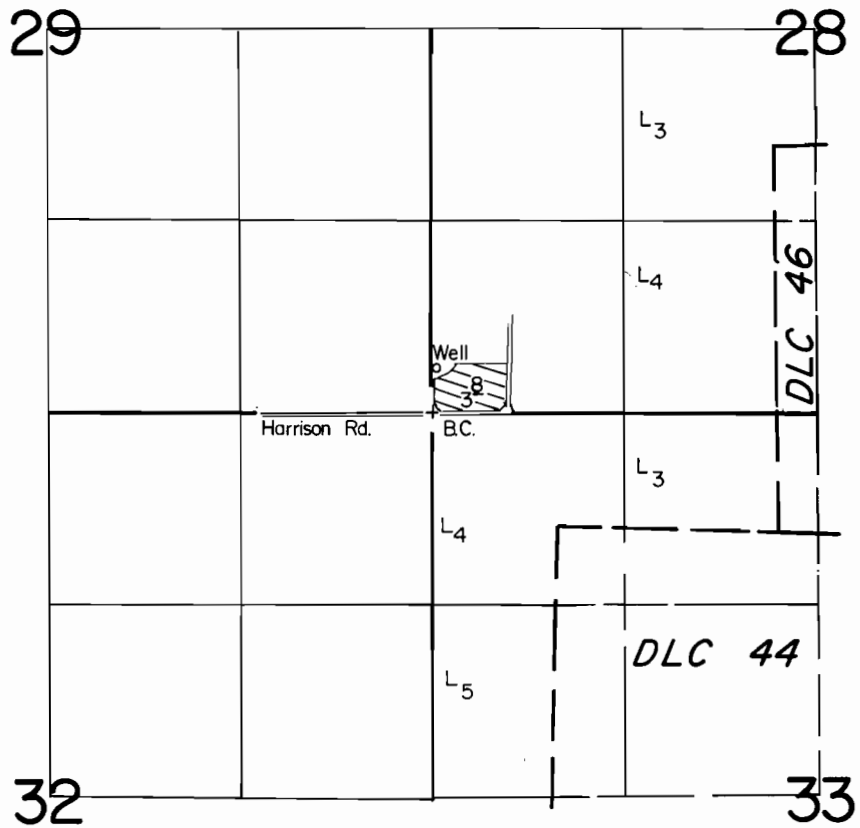

Well Loc. : 330' N. & 30' E. from SW Cor. Sec. 28

Scale : 1" = 1320'

FINAL PROOF SURVEY UNDER

Application No. G-9241 Permit No. G-8564
IN NAME OF

DONALD R. OLSON

Surveyed AUG. 10 1988, by T. Warren