


T.8S., R.2W., W.M.

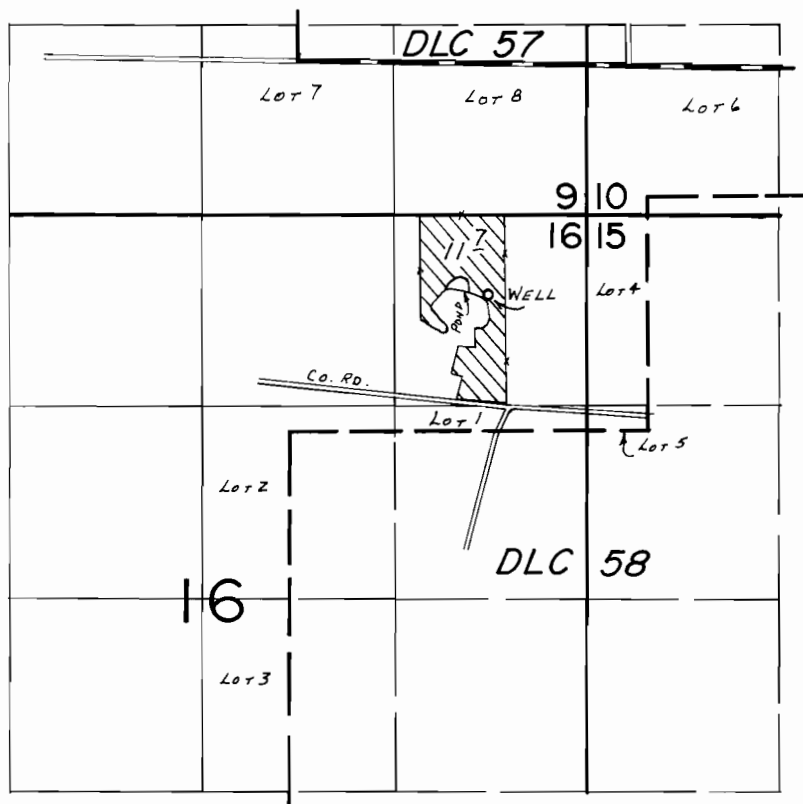

WELL LOC.: 350' S. & 670' W. FROM NE COR. SEC. 16.

SCALE: 1"=1320'

FINAL PROOF SURVEY

UNDER

Application No. G-9436 Permit No. G-8659.....
IN NAME OF

WILLIAM M. & SALLY A. FULLHART

Surveyed July 6..... 1984, by B.W. BISHOP.....