


604 38

MAY 31 1979

Set 5/8" I.R.

set 5/8" I.R.

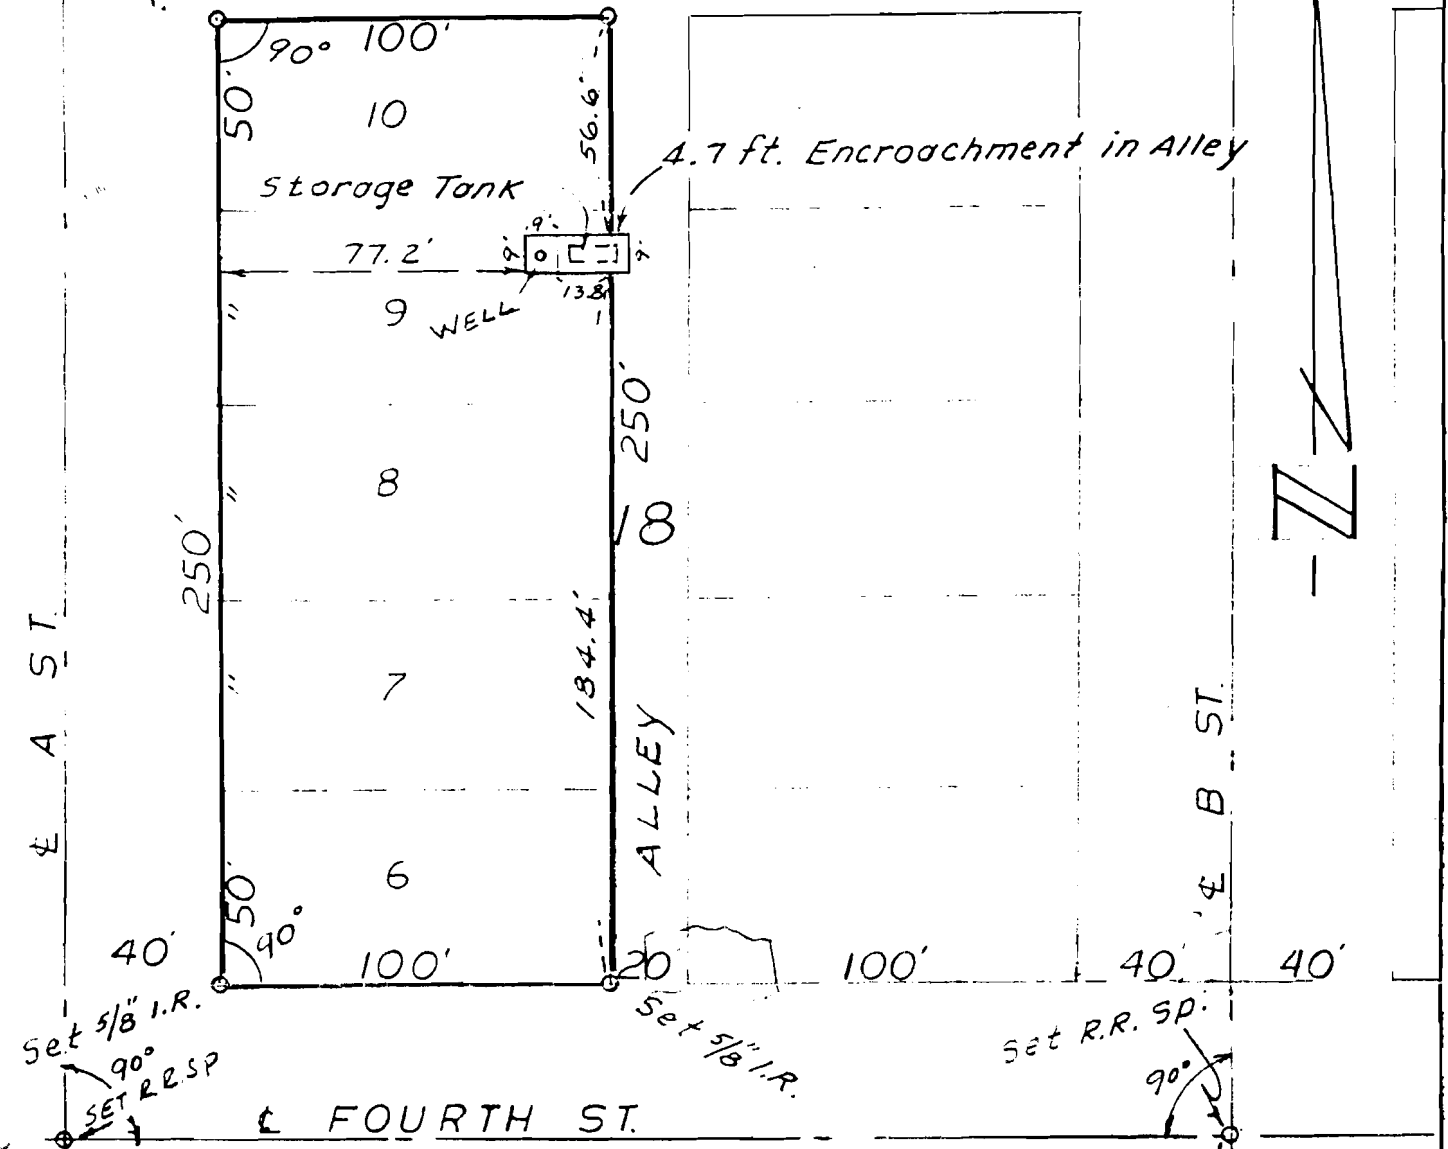

SET. RR SP. 2 → 40'
BLOCK. 6 →
FO 2" I.P. CNW COR.

Cyclone FC. N.E. Cor.
2ND E' B St's

W. LINE BK1
RAGSDALE & MORRISON ADD

OREGON
JULY 13, 1973
LAWRENCE E. JONES
994

Date	No.	Revisions		By	App.
Design	Scale	SURVEY			
Survey	Date	W. 1/2 OF BLOCK 18			
Drawn	Sheet	TROTTER'S 1ST ADDITION			
Appd.	Ckd.	TO KENT, SHERMAN CO.,			
		OREGON.			

TENNESON ENGINEERING CORP. - CONSULTING ENGINEERS - The Dalles - Bend - Oregon

G8663