


# T.6S., R.2W., W.M.

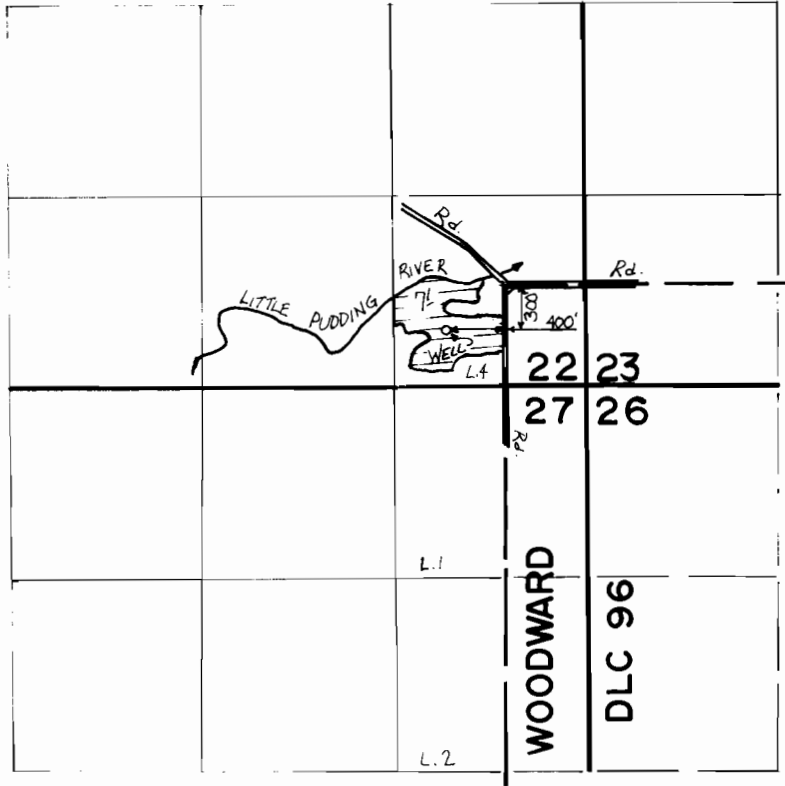

## FINAL PROOF SURVEY UNDER

Application No. **G 9194** Permit No. **G 8666**  
IN NAME OF

**RUBEN E. & ANNA M. BOEHM**

Surveyed **OCT. 25, 1983**, by **M. CAHILL**