


T. 35S., R. 2W., W. M.

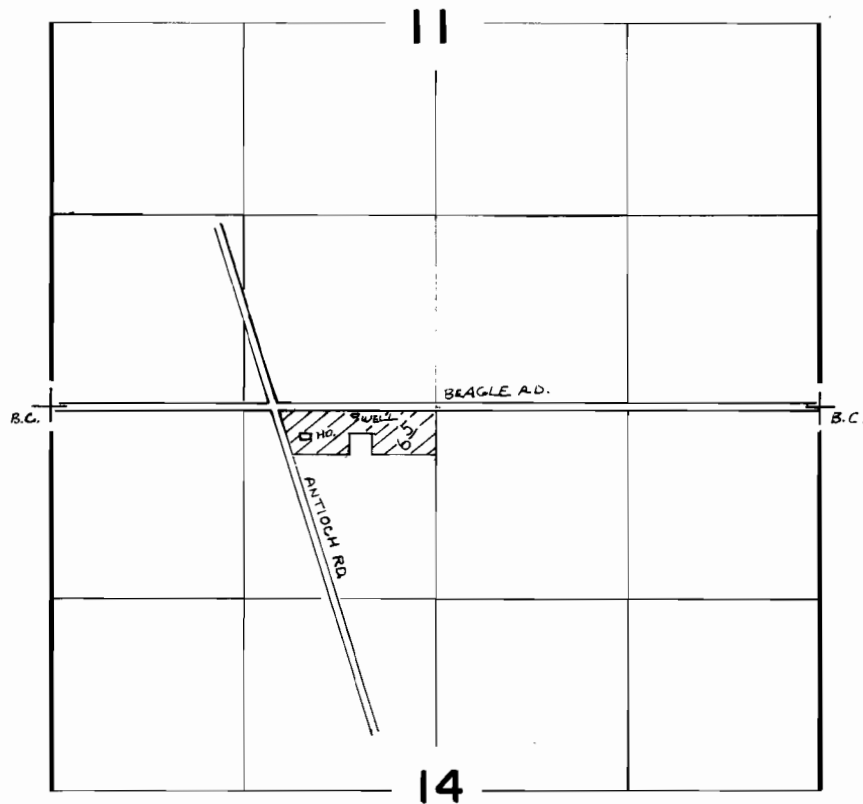

WELL IS 70'S. & 550' W. FROM N. 1/4 COR. SEC. 14

SCALE 1" = 1320'

FINAL PROOF SURVEY UNDER

G-9247 G-8679
Application No. Permit No.
IN NAME OF

HAROLD and/or JUNE HOLDER

OCT. 4 84 J. WOODROOF
Surveyed 19....., by