


T. 32 S., R. 5 W., W.M.

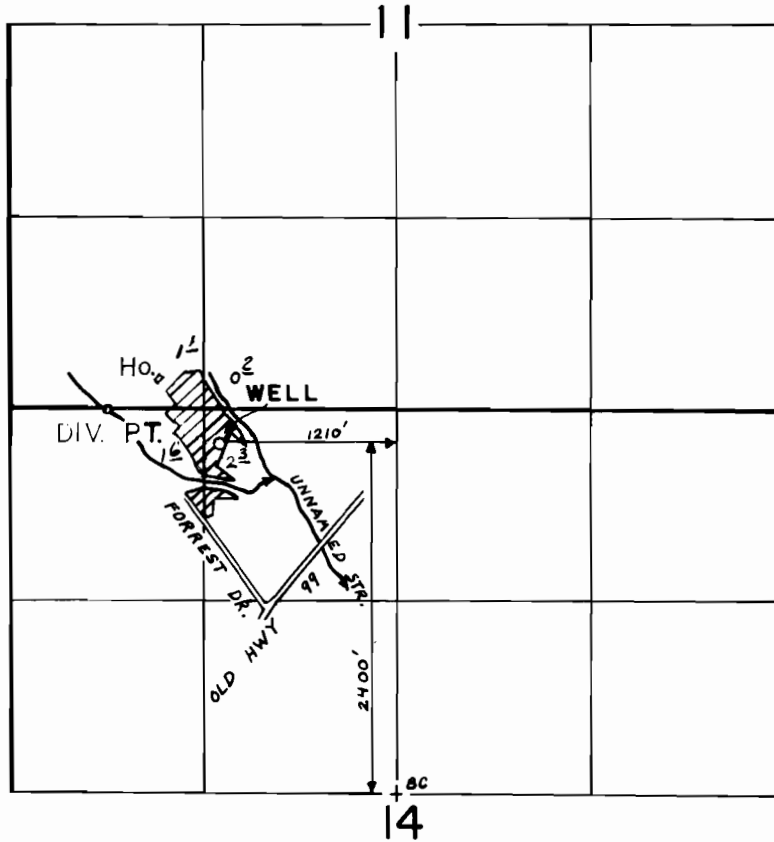

SCALE: 4" = 1 mile

FINAL PROOF SURVEY
UNDER

Application No. G-9240 Permit No. G-8682.
IN NAME OF

WILLIAM E. BELCHER

Surveyed NOV. 16, 19.83, by *Lynn Cashion*

REVISED 1/7/88 JK

41019-278 228A

LEC