


T. 8S., R. 39E., W. M.

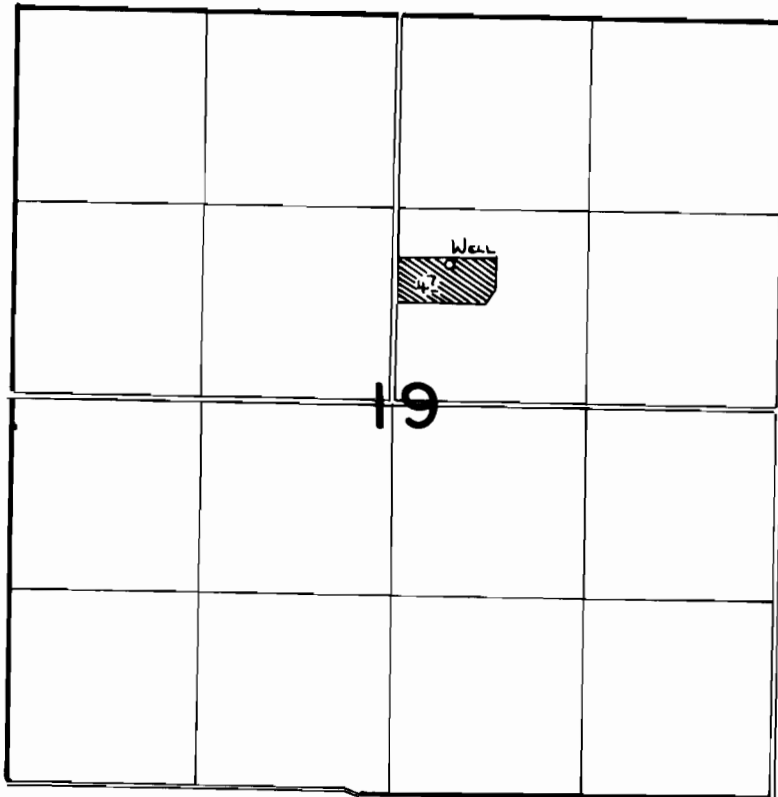

WELL Loc: 960' N. & 370' E. FROM CENTER COR. SEC 19

FINAL PROOF SURVEY
UNDER

SCALE: 1" = 1320'

Application No. **G:9369** Permit No. **G:8731**.....
IN NAME OF

.....**GAYLE L. ANDERSON**.....

Surveyed ..7..12..... 19.87., by *V.L. Church*.....