


T. 8 S., R. 46 E., W.M.

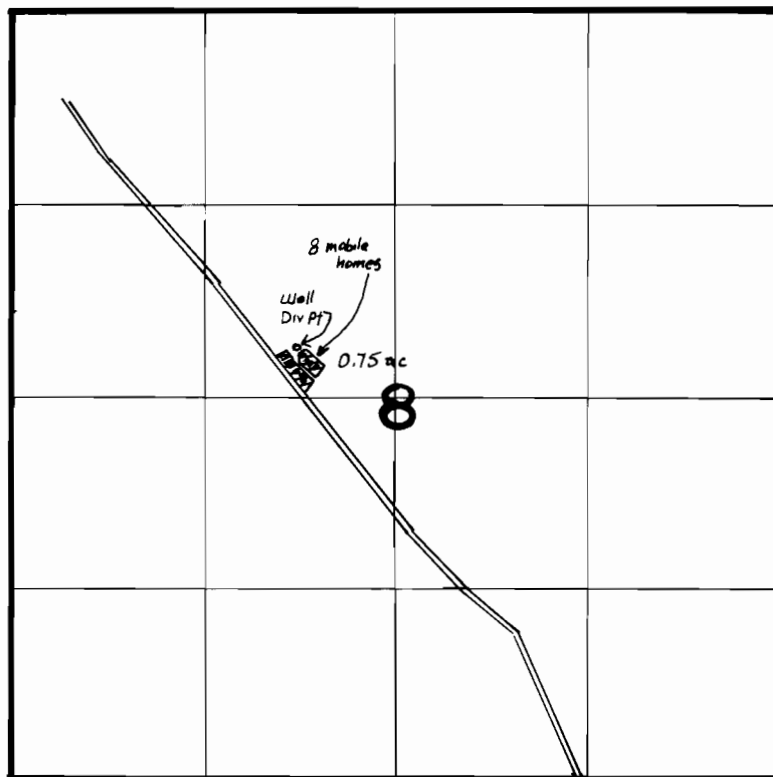

Well is located 330' N. & 650' W. of the center of section 8.

FINAL PROOF SURVEY
UNDER

Application No. **G10766** Permit No. **G9837**
IN NAME OF

FLORENCE HAUGSTED

Surveyed *8-24* 19*88*, by *Kenn Kemp*



Scale 1" = 1320'