


T. 3 S., R. 12 E., W. M.

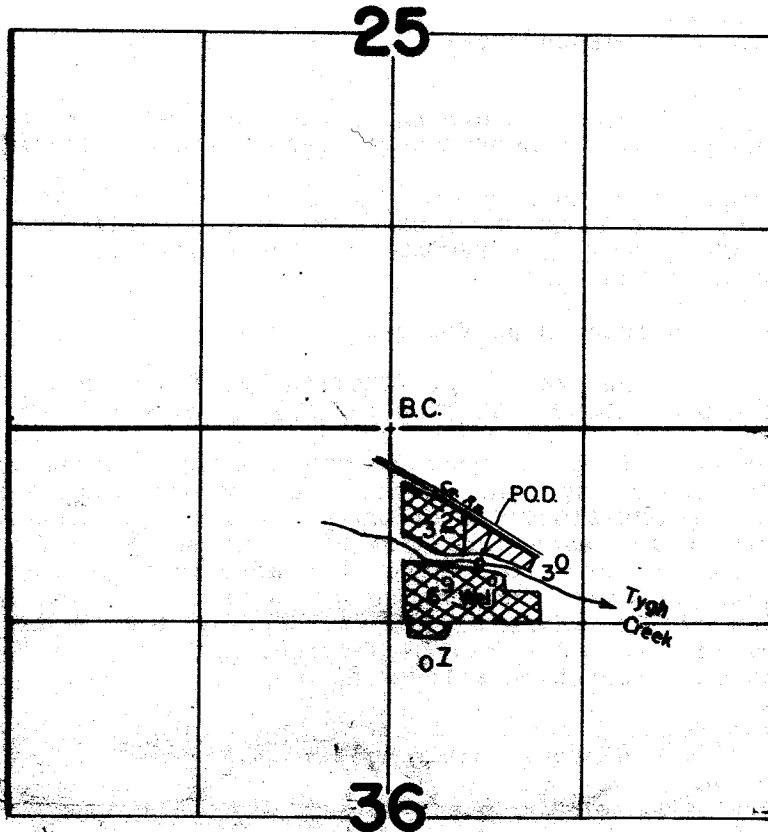

Well Loc.: 1040' S. & 690' E.
 Creek P.O.D. Loc.: 900' S. & 640' E., both from
 N. 1/4 Cor., Section 36.

Scale: 1" = 1320'

FINAL PROOF SURVEY
 UNDER

Application No. **67334** Permit No. **48868**
G-11123 **G-10426**
 IN NAME OF

 PRIMARY
 SUPPLEMENTAL

HAROLD R. & SHIRLEY ANN DELCO

Surveyed **JUNE 8** 19**88**, by **T. Warren**

41065-179-220A
 10/20/08 TAW