


T. 1 S., R. 3 W., W. M.

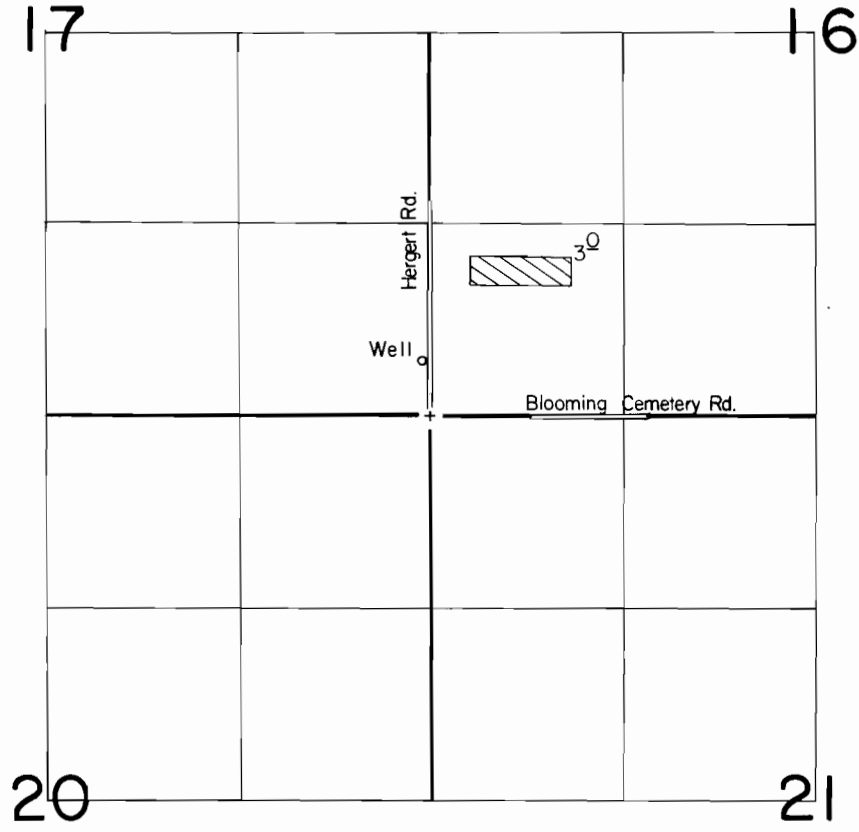

Well Loc. : 340' N. & 40' W. from SW Cor. Sec. 16.

Scale : 1" = 1320'

FINAL PROOF SURVEY UNDER

Application No. G-11155.. Permit No. G-10308..
IN NAME OF

DONALD B. ANDERSON

Surveyed AUG 8 1988., by T. Warren.....