


T. 3S., R. 40E., W.M.

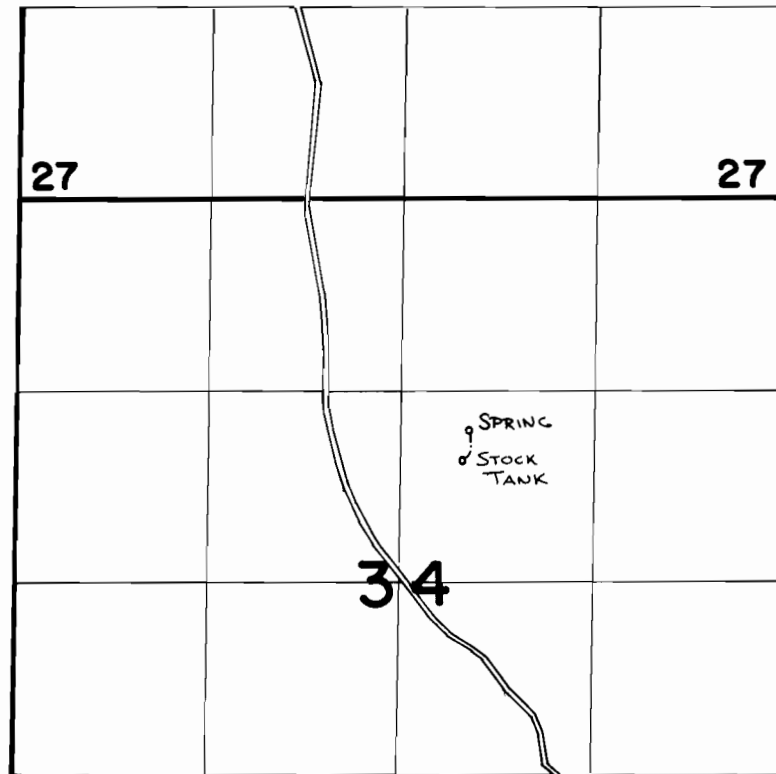

SPRING LOC: 1040' N. & 460' E. FROM CENTER COR.  
SEC 34.



SCALE 1" = 1320'

# FINAL PROOF SURVEY UNDER

Application No. **49323** Permit No. **36977**.....  
IN NAME OF

**FRED & JOYCE WEITLAUF**.....

Surveyed 6-8..... 1988, by V.L. Church.....