
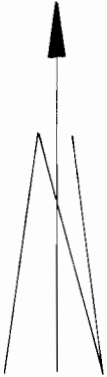


T. 3S., R. 40E., W.M.

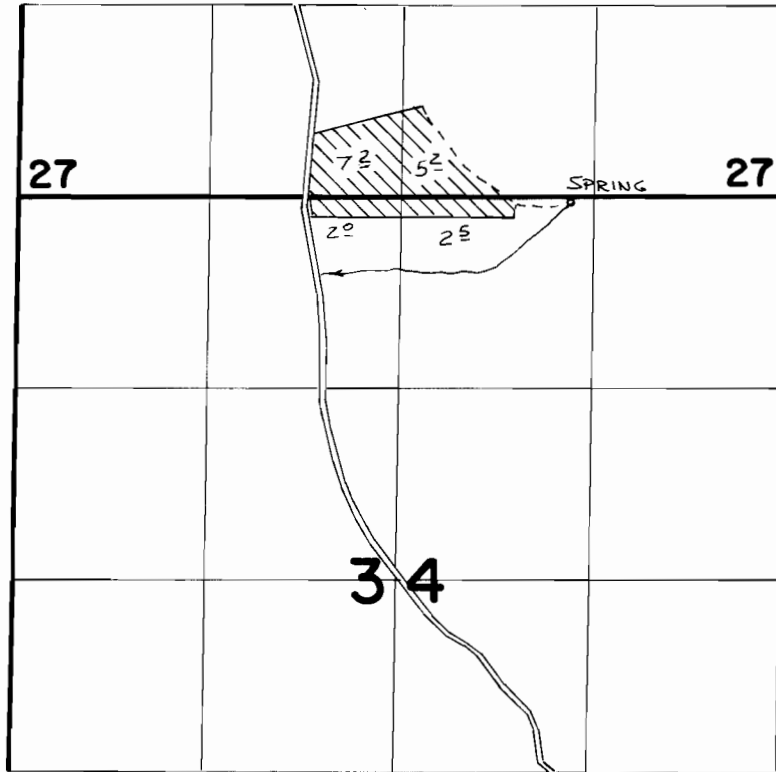

SCALE 1" = 1320'

SPRING LOC: 30'S. & 1460'W. FROM NE CORNER  
SEC 34.

**FINAL PROOF SURVEY**  
UNDER

Application No. **49799** Permit No. **37464**  
IN NAME OF

**ROBERT J. GIRDNER**

Surveyed ~~9-22~~ 1987, by *V.L. Church*