



# T. 8S., R. 45 & 46E., W.M.

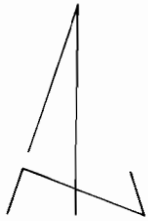

SCALE 1" = 1320'

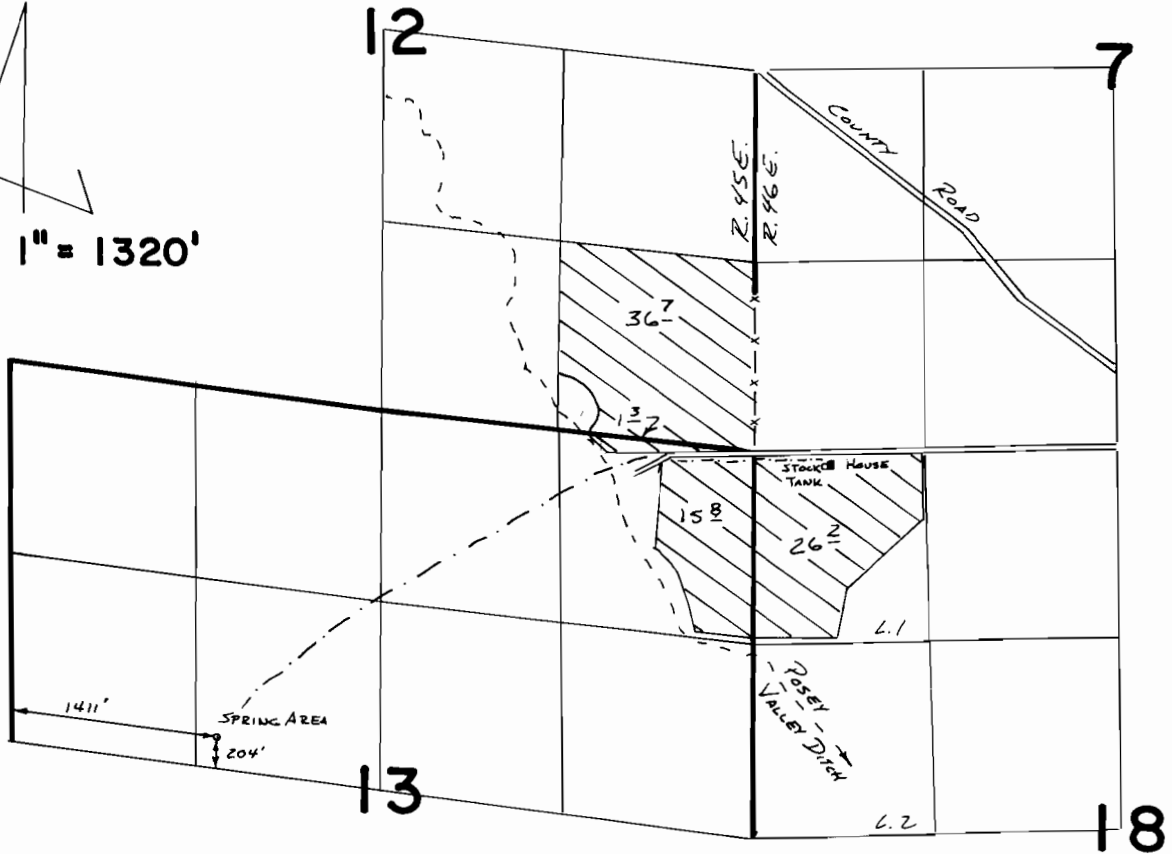

## FINAL PROOF SURVEY UNDER

Application No. **52575**. Permit No. **39814**.....  
IN NAME OF

.....**JOSEPH I. PINAIRE**.....

Surveyed ...**8-3**..... 19**88**, by **V.L. CHURCH**.....