


T. 6S., R. 39E., W. M.

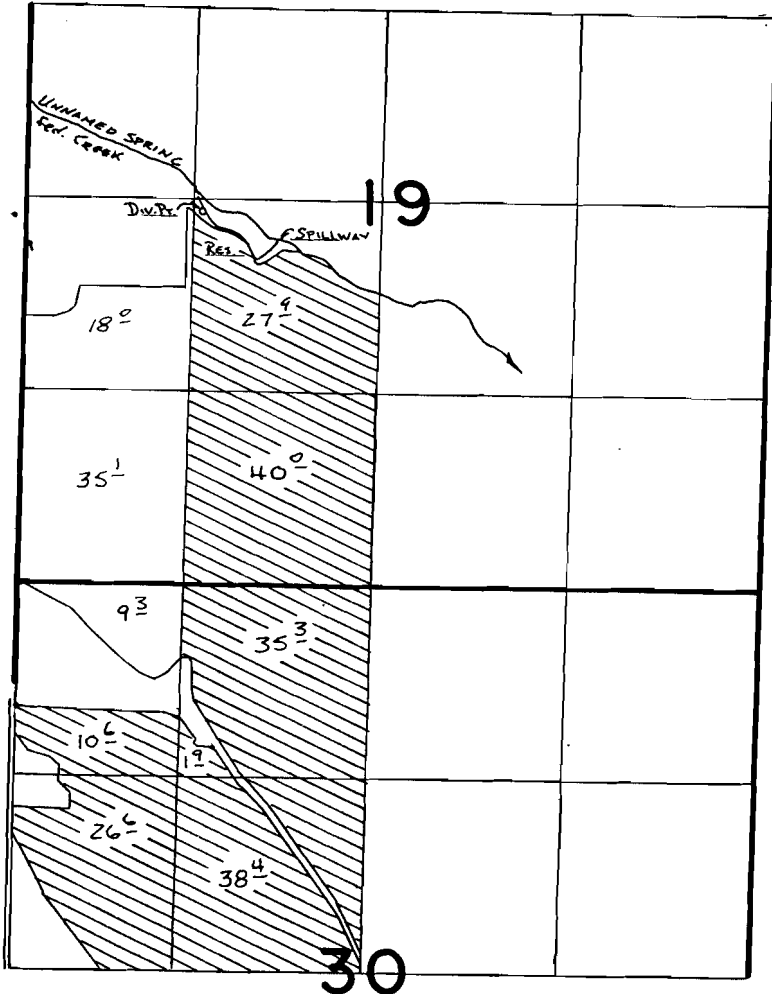

Div. Pt. Loc: 80'S. & 1250'W. FROM CENTER COR. SEC. 19.

SCALE 1" = 1320'

FINAL PROOF SURVEY
UNDER

R-55903 R-6589
Application No. **55904** Permit No. **41563**.....
IN NAME OF

.....**RONALD V. MOE**.....

Surveyed ~~8~~..... 19~~8~~⁴., by ~~V. L. Church~~.....

BBB-4KK-251
41061-179-22712

VLC