


T. 6S., R. 39E., W. M.

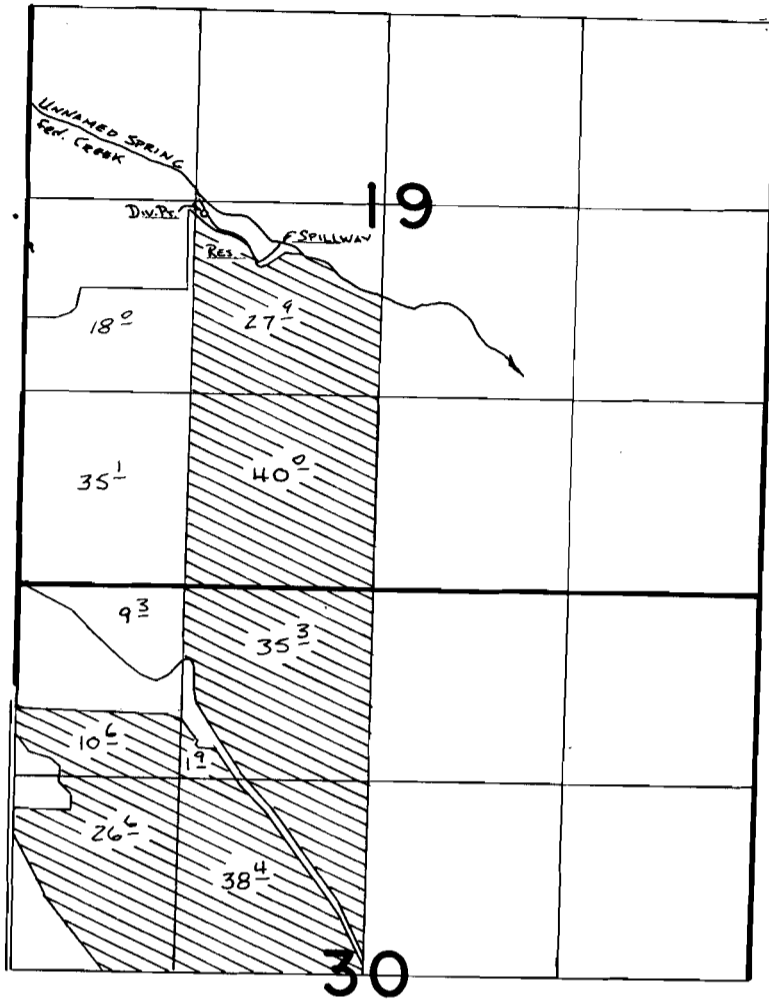

Div. Pt. Loc: 80'S. & 1250' W. FROM CENTER COR. SEC. 19.

SCALE 1" = 1320'

**FINAL PROOF SURVEY**  
UNDER

R-55903                      R-6589  
Application No. 55904. Permit No. 41563.....  
IN NAME OF

.....RONALD V. MOE.....

Surveyed 8-1-1984, by V.L. Church.....

BBB-4KK-251  
41061-179-22712

VLC